


CERTIFIED RECORD OF LAND CORNER MONUMENTATION

Index File Number H-5

History of original corner establishment:

Not Set.

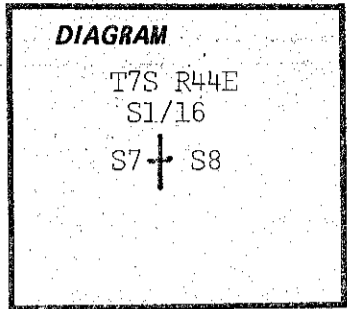

Description of corner evidence found:

None Found.

Description of monument and accessories I established to perpetuate the original location of this corner:

At surveyed point set 2 1/2" X 30" galvanized pipe and brass cap marked:  
Set pipe 26" in the ground and mound of stone around to cap.

T7S R44E  
S1/16  
S7 + S8  
OR PLS 1051  
1982

From which by magnetic declination of N20°E:  
A 12" Pine bears N53°E, 16.9 ft. scribed S1/16 S8 BT.  
A 14" Pine bears S34°W, 17.0 ft. scribed S1/16 S7 BT. Painted blazes red and 6" red band around. Placed 54-3s, 54-9s and brass washers stamped PLS 1051 on the bearing trees. Placed 54-2 and 54-9 on a steel fence post 5' north and placed 54-2 on a steel fence post 5' east of the corner.

I hereby certify that the above corner monument was established as herein described.

Witnesses: Larry D. Shirley  
Michael L. Cain

October 18, 1982.

REGISTERED  
PROFESSIONAL  
LAND SURVEYOR

*Barry B. Barbour*

OREGON  
OCT. 17, 1975  
BARRY B. BARBOUR  
1051

Office of.....County Surveyor..... County of.....Baker.....  
Oregon  
State of....., I hereby certify that the within instrument was filed in this office  
for record on the..... day of....., 1985

..... by .....  
(COUNTY OFFICIAL) (DEPUTY)

FILED 11-7-85  
BAKER COUNTY SURVEYOR  
SURVEY NO. 7-44-92