


CERTIFIED RECORD OF LAND CORNER MONUMENTATION

Index File Number H-6

History of original corner establishment:

Not Set.

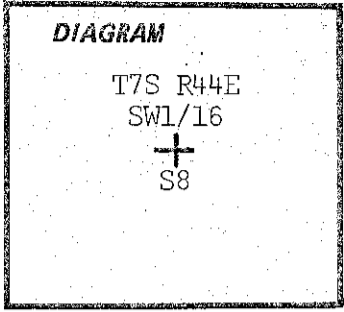

Description of corner evidence found:

None Found.

Description of monument and accessories established to perpetuate the original location of this corner:

At surveyed point set 2 1/2" X 30" galvanized pipe and brass cap marked:
Set pipe 26" in the ground and mound of stone around to cap.

T7S R44E
SW 1/16
+
S8
OR PLS 1051
1982

From which by magnetic declination of N20°E:
A 10" Fir bears N18°E, 13.2 ft. scribed SW 1/16 S8 BT.
A 15" Fir bears S50°W, 25.6 ft. scribed SW 1/16 S8 BT. Painted blazes red and 6" red band around. Placed 54-3s, 54-9s and brass washers stamped PLS 1051 on the bearing trees. Placed 54-2 and 54-9 on a steel fence post 5' south and placed 54-2 on a steel fence post 5' west of the corner.

I hereby certify that the above corner monument was established as herein described.

Witnesses: Larry D. Shirley
Michael L. Cain

November 8, 1982.

REGISTERED
PROFESSIONAL
LAND SURVEYOR

Barry B. Barbour

OREGON
OCT. 17, 1975
BARRY B. BARBOUR
1051

Office of.....County Surveyor..... County of.....Baker.....
State of.....Oregon....., I hereby certify that the within instrument was filed in this office
for record on the..... day of....., 1985.

..... by
(COUNTY OFFICIAL) (DEPUTY)

FILED 11-7-85
BAKER COUNTY SURVEYOR
SURVEY NO. 7-44-93