


CERTIFIED RECORD OF LAND CORNER MONUMENTATION

Index File Number J-7

History of original corner establishment:

Corner was originally established under G. L. O. contract number 503, by W. B. Barr, on August 17, 1884. Surveyor General's notes state: "Set basalt rock 12 X 12 X 6 ins. 8 inches in ground for 1/4 sec. cor. marked 1/4 on N. side. From which a fir 8 ins. diam. bears N62°E, 28 lks. dist. marked 1/4S BT. A fir 4 ins. diam. bears S12°E, 30 lks. dist. marked 1/4S BT."

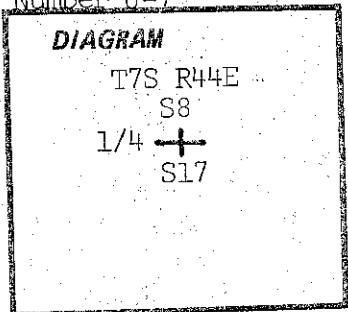

Description of corner evidence found:

Found no trace of record stone or bearing trees. Very little rock in the area. The surveyed position is on the east bank of an old mining ditch.

Description of monument and accessories I established to perpetuate the original location of this corner:

At surveyed point set 2 1/2" X 30" galvanized pipe and brass cap marked:  
Set pipe 26" in the ground. No rock in the area.  
From which by magnetic declination of N20°E:  
A 9" Fir bears S43°E, 23.1 ft. scribed 1/4 S17 BT.  
An 11" Fir bears N77°W, 10.5 ft. scribed 1/4 S8 BT.  
Painted blazes red and 6" red band around. Placed 54-3s, 54-4s and brass washers stamped PLS 1051 on the bearing trees. Placed 54-4 on a steel fence post 5' south of the corner.

T7S R44E  
S8  
1/4  
S17  
OR PLS 1051  
1982

I hereby certify that the above corner monument was reestablished as herein described.

Witnesses: Larry D. Shirley  
Michael L. Cain

October 21, 1982.

REGISTERED  
PROFESSIONAL  
LAND SURVEYOR

*Barry B. Barbour*

OREGON  
OCT. 17, 1975  
BARRY B. BARBOUR  
1051

Office of.....County Surveyor..... County of.....Baker.....  
State of.....Oregon....., I hereby certify that the within instrument was filed in this office  
for record on the..... day of....., 19.85  
..... by .....  
(COUNTY OFFICIAL) (DEPUTY)

FILED 11-7-85  
BAKER COUNTY SURVEYOR  
SURVEY NO. 7-44-96