


CERTIFIED RECORD OF LAND CORNER MONUMENTATION

Index File Number J-19

History of original corner establishment:

Corner was originally established under G. L. O. contract number 503, by W. B. Barr, during August 5, 1884. Surveyor General's notes state: "Set slate stone 12 X 10 X 10 ins. 8 inches in ground for 1/4 sec. cor. marked 1/4 on the N. side. Raised mound of rock alongside: Ppits impracticable."

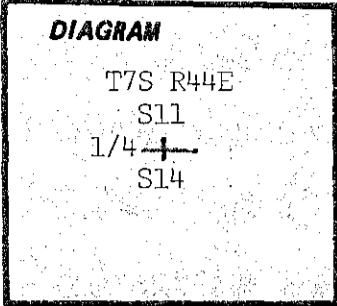


Description of corner evidence found:

Found no trace of record stone or mound. Corner falls on open rocky slope, near a rock pit.

Description of monument and accessories established to perpetuate the original location of this corner:

At surveyed point set 2 1/2" X 30" galvanized pipe and brass cap marked:
Set pipe 22" in the ground and mound of stone around to cap.

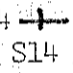T7S R44E
S11
1/4 
S14
OR PLS 1051
1983

From which by magnetic declination of N20°E:
A 9" Pine bears S14°W, 8.8 ft. scribed 1/4 S14 BT.
A 14" Pine bears N38°W, 61.5 ft. scribed 1/4 S11 BT. Painted blazes red and 6" red band around. Placed 54-3s, 54-4s and brass washers stamped PLS 1051 on the bearing trees. Placed 54-4 on a steel fence post 5' west of the corner.

I hereby certify that the above corner monument was reestablished as herein described.

Witnesses: Larry D. Shirley
Troy A. Slobig

October 18, 1983.

REGISTERED
PROFESSIONAL
LAND SURVEYOR

Barry B. Barbour

OREGON
OCT. 17, 1975
BARRY B. BARBOUR
1051

Office of.....County.....Surveyor..... County of.....Baker.....
State of.....Oregon..... I hereby certify that the within instrument was filed in this office
for record on the..... day of....., 1985
..... by
(COUNTY OFFICIAL) (DEPUTY)

Form R6-7100-57 (9/71)

FILED 11-7-85
BAKER COUNTY SURVEYOR
SURVEY NO. 7-44-97