


CERTIFIED RECORD OF LAND CORNER MONUMENTATION

Index File Number J-21

History of original corner establishment:

Corner was originally established under G. L. O. contract number 503, by W. B. Barr, during August 1, 1884. Surveyor General's notes state: "Set sandstone 18 X 14 X 12 ins. 12 inches in ground for cor. to secs. 11, 12, 13 & 14, marked with 4 notches on the S. and 1 notch on the E. edges." Raised mound of rock alongside. Pits impracticable."

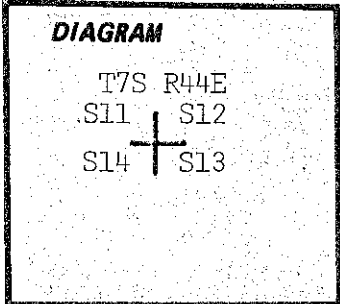

Description of corner evidence found:

Found no trace of record stone or mound.

Description of monument and accessories established to perpetuate the original location of this corner:

At surveyed point set 2 1/2" X 30" galvanized pipe and brass cap marked; Set pipe 26" in the ground and mound of stone around to cap.

T7S R44E  
S11 S12  
S14 S13  
OR PLS 1051  
1983

From which by magnetic declination of N20°E:  
A 16" Fir bears N10°E, 35.2 ft. scribed T7S R44E S12 BT.  
A 14" Fir bears S57°E, 12.1 ft. scribed T7S R44E S13 BT. An 8" Fir bears S75°W, 4.9 ft. scribed T7S R44E S14 BT. A 9" Fir bears N17°W, 44.3 ft. scribed T7S R44E S11 BT. Painted blazes red and 6" red band around. Placed 54-3s, 54-4s and brass washers stamped PLS 1051 on the bearing trees. Placed 54-4 on a steel fence post 5' north of the corner.

I hereby certify that the above corner monument was reestablished as herein described.

Witnesses: Larry D. Shirley  
Troy A. Slobig

October 18, 1983.

REGISTERED  
PROFESSIONAL  
LAND SURVEYOR

*Barry B. Barbour*

OREGON  
OCT. 17, 1975  
BARRY B. BARBOUR  
1051

Office of.....County Surveyor..... County of.....Baker.....  
State of.....Oregon....., I hereby certify that the within instrument was filed in this office  
for record on the..... day of....., 1985.

..... by .....  
(COUNTY OFFICIAL) (DEPUTY)

FILED 11-7-85  
BAKER COUNTY SURVEYOR  
SURVEY NO. 7-44-98