


CERTIFIED RECORD OF LAND CORNER MONUMENTATION

Index File Number L-9

History of original corner establishment:

Corner was originally established under G. L. O. contract number 503, by W. B. Barr, during August 8, 1884. Surveyor General's notes state: "Set basalt rock 14 X 9 X 9 ins., 10 ins. in ground for 1/4 sec. cor. marked 1/4 on the W. side, from which a fir 5 ins. diam. bears S16°W, 28 lks. dist. marked 1/4S BT. A fir 4 ins. diam. bears N22°E, 36 lks. dist. marked 1/4S BT."

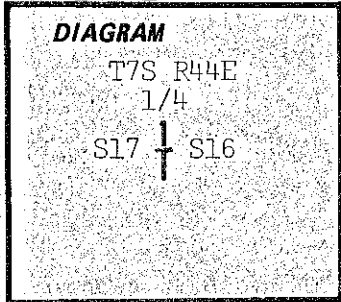

Description of corner evidence found:

Found no trace of record stone or bearing trees. Surveyed point falls in Eagle Creek. Barr's position is on very steep, unstable ground on the west side of creek.

Description of monument and accessories established to perpetuate the original location of this corner:

At surveyed point set 2 1/2" X 30" aluminum pipe and cap marked:

Set pipe 24" in the ground and mound of stone around to cap.

Corner falls in Eagle Creek and Witness Corner is set for

1/4 section corner at a point N01° 38' 54"W, 85.2 feet.

From which by magnetic declination of N20°E:

A 10" Pine bears N33°E, 58.3 ft. scribed WC 1/4 S16 BT. An

18" Pine bears S84°W, 30.3 ft. scribed WC 1/4 S17 BT. Painted blazes red and 6" red band around. Placed 54-3s, 54-4s and brass washers stamped PLS 1051 on the bearing trees. Placed 54-4 on a steel fence post 5' west of the corner.

WC 85.2 FT. NO. T7S R44E 1/4 S17 + S16 OR PLS 1051 1985

I hereby certify that the above corner monument was reestablished as herein described.

Witness: Van K. Barbour

August 23, 1985.

REGISTERED PROFESSIONAL LAND SURVEYOR

BARRY B. BARBOUR OREGON OCT. 17, 1975 BARRY B. BARBOUR 1051

Office of... County Surveyor's... County of... Baker

State of... Oregon... I hereby certify that the within instrument was filed in this office

for record on the... day of... , 19.85

(COUNTY OFFICIAL)

(DEPUTY)

FILED 11-7-85 BAKER COUNTY SURVEYOR SURVEY NO. 7-44-102