


CERTIFIED RECORD OF LAND CORNER MONUMENTATION

Index File Number N-7

History of original corner establishment:

Corner was originally established under G. L. O. contract number 503, by W. B. Barr, on August 16, 1884. Surveyor General's notes state: "Set basalt rock 10 X 10 X 6 ins. 7 inches in ground for 1/4 sec. cor. marked 1/4 on the N. side. From which a fir 6 ins. diam. bears S70°W, 34 lks. dist. marked 1/4S BT. A fir 18 ins. diam. bears N45°E, 20 lks. dist. marked 1/4S BT."

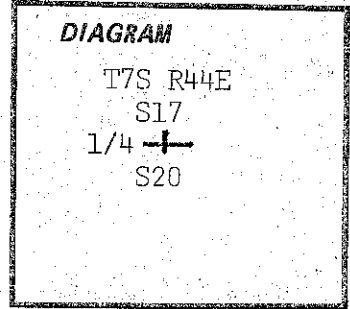


Description of corner evidence found:

Found set 12 X 10 X 8 inch basalt stone, clearly marked 1/4 on north face. From which a rotten and burnt 30" fir stump bears N45°E, 13.5 ft. South-west bearing trees falls in skid area and no trace could be found.

Description of monument and accessories I established to perpetuate the original location of this corner:

At center of the above stone, set 2 1/2" X 30" galvanized pipe and brass cap marked:
 Set pipe 24" in the ground and mound of stone around to cap. Buried marked stone alongside.
 From which by magnetic declination of N20°E:
 A 9" Fir bears N40°E, 16.4 ft. scribed 1/4 S17 BT. A 16" Fir bears S25°W, 12.0 ft. scribed 1/4 S20 BT. Painted blazes red and 6" red band around. Placed 54-3s, 54-4s and brass washers stamped PLS 1051 on the bearing trees. Placed 54-4 on a steel fence post 5' west of the corner.

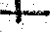T7S R44E
 S17
 1/4 
 S20
 OR PLS 1051
 1982

I hereby certify that the above corner monument was reestablished as herein described.

Witnesses: Larry D. Shirley
Terry J. Anderson

September 20, 1982.

REGISTERED
 PROFESSIONAL
 LAND SURVEYOR

Barry B. Bargar

OREGON
 OCT. 17, 1975
 BARRY B. BARGOUR
 1051

Office of.....County Surveyor..... County of..... Baker
 State of.....Oregon....., I hereby certify that the within instrument was filed in this office
 for record on the..... day of....., 1985.

(COUNTY OFFICIAL)

(DEPUTY)

FILED 11-7-85

BAKER COUNTY SURVEYOR

SURVEY NO. 7-44-104