


CERTIFIED RECORD OF LAND CORNER MONUMENTATION

Index File Number N-19

History of original corner establishment:

Corner was originally established under G. L. O. contract number 503, by W. B. Barr, on August 5, 1884. Surveyor General's notes state: "Set post 4 ft. long 4 ins. sq. 24 inches in ground for 1/4 sec. cor. marked 1/4 on N. side. From which a pine 18 ins. diam. bears N15°W, 42 lks. dist. marked 1/4S BT. A pine 12 ins. diam. bears S40°W, 32 lks. dist. marked 1/4S BT."

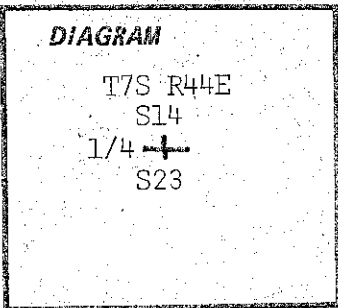

In 1974 the BLM remonumented this corner. Official notes state: "The 1/4 sec. cor. of secs. 14 and 23, determined from the remains of the original bearing trees. At the corner point. Set an iron post, 28 ins. long, 2 1/2 ins. diam., 20 ins. in the ground to bedrock, and in a mound of stone, 1 1/2 ft. base, to top, with brass cap mkd."
(SEE BELOW FOR NEW BEARING TREES.)

T7S R44E
S14
1/4
S23
1974

Description of corner evidence found:

Found no trace of BLM monument. Corner falls in recent logging road. The original bearing trees are as described by the BLM remonumentation notes and the recent BLM bearing trees are as described.

BLM. "From which new bearing trees. A fir, 9 ins. diam., bears S71°W, 49 lks. dist., mkd. 1/4 S23 BT. A white fir, 11 ins. diam., bears S41°W, 58 lks. dist., mkd. 1/4 S14 BT."

Description of monument and accessories established to perpetuate the original location of this corner:

From the BLM trees, measured from a 15" Fir, S41°E, 38.4 ft. and from an 11" Fir, N71°E, 32.0 ft. At this point set 2 1/2" X 30" galvanized pipe and brass cap marked: Set pipe 26" in the ground and mound of stone around to cap.

T7S R44E
S14
1/4
S23
OR PLS 1051
1982

The old G. L. O. bearing trees are:
A 30" Pine bears S40°W, 28.4 ft. with grown over blazes. A 24" Pine stump bears N15°W, 28.4 ft. with visible scribing. Trees have 54-3s and 54-4s. Blazes painted red and 6" red band around. Placed 54-4 on a steel fence post 4' north of the corner.

I hereby certify that the above corner monument was reestablished as herein described.

Witnesses: Larry D. Shirley
Daniel T. Rowland

June 16, 1982.

**REGISTERED
PROFESSIONAL
LAND SURVEYOR**

Barry B. Barbour

OREGON
OCT. 17, 1975
BARRY B. BARBOUR
1051

Office of.....County Surveyor..... County of.....Baker.....
State of.....Oregon....., I hereby certify that the within instrument was filed in this office
for record on the..... day of....., 19.85

(COUNTY OFFICIAL)

(DEPUTY)

FILED 11-7-85
BAKER COUNTY SURVEYOR
SURVEY NO. 2-44-108