


CERTIFIED RECORD OF LAND CORNER MONUMENTATION

Index File Number N23

History of original corner establishment:

Corner was originally established under G. L. O. contract number 503, by W. B. Barr, during August 1, 1884. Surveyor General's notes state: "Set post 4 ft. long, 4 ins. diam. 24 inches in ground for 1/4 sec. cor. marked 1/4S on N. side. From which a pine 20 ins. diam. bears S89°W, 84 lks. dist. marked 1/4S BT. A tamarack 18 ins. diam. bears N85°E, 42 lks. dist. marked 1/4S BT."

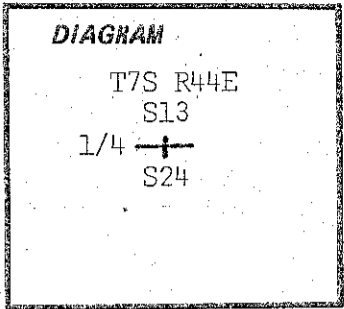

Description of corner evidence found:

Found no trace of record post or bearing trees. Corner area has lots of low cut rotten stumps.

Description of monument and accessories established to perpetuate the original location of this corner:

At surveyed point set 2 1/2" X 30" galvanized pipe and brass cap marked:
Set pipe 22" in the ground and mound of stone around to cap.

T7S R44E
S13
1/4
S24
OR PLS 1051
1982

From which by magnetic declination of N20°E:
A 20" Fir bears N70°E, 21.6 ft. scribed 1/4 S13 BT.
An 11" Fir bears S21°E, 21.0 ft. scribed 1/4 S24 BT. Painted blazes red and 6" red band around. Placed 54-3s, 54-4s and brass washers stamped PLS 1051 on the bearing trees. Placed 54-4 on a steel fence post 5' west of the corner.

I hereby certify that the above corner monument was reestablished as herein described.

Witnesses: Larry D. Shirley
Daniel T. Rowland

June 22, 1982.

REGISTERED
PROFESSIONAL
LAND SURVEYOR

Barry B. Barbour

OREGON
OCT. 17, 1975
BARRY B. BARBOUR
1051

Office of.....County Surveyor..... County of..... Baker.....
State of..... Oregon....., I hereby certify that the within instrument was filed in this office
for record on the..... day of....., 1985.

..... by

(COUNTY OFFICIAL)

(DEPUTY)

FILED 11-7-85
BAKER COUNTY SURVEYOR
SURVEY NO. 7-44-109