


CERTIFIED RECORD OF LAND CORNER MONUMENTATION

Index File Number P-13

History of original corner establishment:

Corner was originally established under G. L. O. contract number 503, by W. B. Barr, during August 9, 1884. Surveyor General's notes state: "Set limestone 16 X 10 X 10 ins., 11 inches in ground for 1/4 sec. cor. marked 1/4 on the W. side. From which a pine 36 ins. diam. bears N85°W, 25 lks. dist. marked 1/4 S BT. A pine 12 ins. diam. bears S14 1/2°E, 97 lks. dist. marked 1/4 S BT."

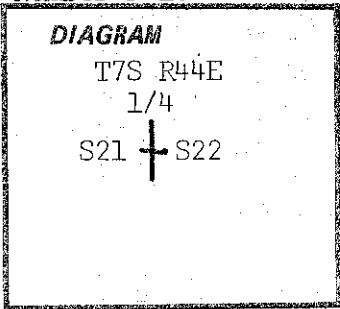

Description of corner evidence found:

Found no trace of record stone or bearing trees. Corner falls near a road and logged area.

Description of monument and accessories established to perpetuate the original location of this corner:

At surveyed point set 2 1/2" X 30" aluminum pipe and cap marked:
Set pipe 20" in the ground and mound of stone around to cap.

T7S R44E
1/4
S21 + S22
OR PLS 1051
1984

From which by magnetic declination of N20°E:
An 18" Pine bears N30°E, 11.0 ft. scribed 1/4 S22 BT.
An 18" Pine bears S65°W, 76.6 ft. scribed 1/4 S21 BT. Painted blazes red and 6" red band around. Placed 54-3s, 54-4s and brass washers stamped PLS 1051 on the bearing trees. Placed a 54-4 on a steel fence post 5' north of the corner.

I hereby certify that the above corner monument was reestablished as herein described.

Witnesses: Michael E. Marks
Robert W. Wilson

November 19, 1984

REGISTERED
PROFESSIONAL
LAND SURVEYOR

Barry B. Barbour

OREGON
OCT. 17, 1975
BARRY B. BARBOUR
1051

Office of..... County Surveyor..... County of..... Baker
State of..... Oregon....., I hereby certify that the within instrument was filed in this office
for record on the..... day of....., 19..85
..... by

(COUNTY OFFICIAL)

(DEPUTY)

FILED 11-7-85
BAKER COUNTY SURVEYOR
SURVEY NO. 7-44-112