


CERTIFIED RECORD OF LAND CORNER MONUMENTATION

Index File Number P-19

History of original corner establishment:

Not Set.

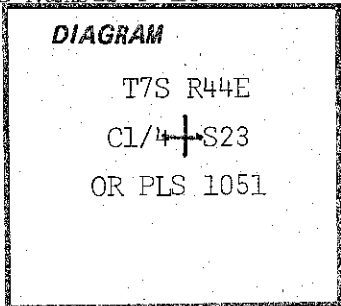

Description of corner evidence found:

None Found.

Description of monument and accessories established to perpetuate the original location of this corner:

At surveyed point set 2 1/2" X 30" galvanized pipe and brass cap marked:  
 Set pipe 10" in the ground to bedrock and mound of stone around to cap.

T7S R44E  
 C1/4 + S23  
 OR PLS 1051  
 1982

From which by magnetic declination of N20°E:  
 A 15" Fir bears S74°E, 31.0 ft. scribed C1/4 S23 BT. A 16" Fir bears N59°W, 38.0 ft. scribed C1/4 S23 BT. Painted blazes red and 6" red band around. Placed 54-3s, 54-9s and brass washers stamped PLS 1051 on the bearing trees. Placed 54-2 and 54-9 on a steel fence post 5' north and 54-2 on a steel fence post 5' west of the corner.

I hereby certify that the above corner monument was established as herein described.

Witnesses: Larry D. Shirley  
 Daniel T. Rowland

June 15, 1982.

REGISTERED  
 PROFESSIONAL  
 LAND SURVEYOR

OREGON  
 OCT. 17, 1975  
 BARRY B. BARBOUR  
 1051

Office of.....County Surveyor..... County of.....Baker.....  
 State of.....Oregon....., I hereby certify that the within instrument was filed in this office  
 for record on the..... day of....., 19.85

..... by .....  
 (COUNTY OFFICIAL) (DEPUTY)

FILED 11-7-85  
 BAKER COUNTY SURVEYOR  
 SURVEY NO. 7-44-114