


CERTIFIED RECORD OF LAND CORNER MONUMENTATION

Index File Number P-23

History of original corner establishment:

Not Set.

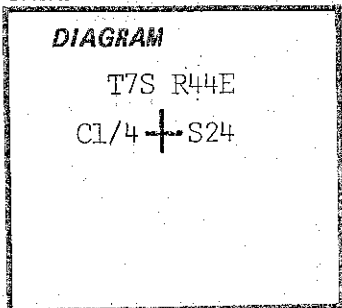

Description of corner evidence found:

None Found.

Description of monument and accessories established to perpetuate the original location of this corner:

At surveyed point set 2 1/2" X 30" galvanized pipe and brass cap marked:
 Set pipe 15" in the ground and mound of stone around to cap.

T7S R44E
 C1/4 + S24
 OR PLS 1051
 1982

From which by magnetic declination of N20°E:
 A 13" pine bears N86°E, 35.5 ft. scribed C1/4 S24 BT. A 14" Pine bears N43°W, 51.6 ft. scribed C1/4 S24 BT. Painted blazes red and 6" red band around. Placed 54-3s, 54-9s and brass washers stamped PLS 1051 on the bearing trees. Placed 54-9 on a steel fence post 5' east of the corner.

I hereby certify that the above corner monument was established as herein described.

Witnesses: Larry D. Shirley
 Daniel T. Rowland

July 12, 1982.

REGISTERED
 PROFESSIONAL
 LAND SURVEYOR

Barry B. Barbour
 OREGON
 OCT. 17, 1975
 BARRY B. BARBOUR
 1051

Office of.....County Surveyor..... County of..... Baker
 State of..... Oregon....., I hereby certify that the within instrument was filed in this office
 for record on the..... day of....., 19..85

..... by
 (COUNTY OFFICIAL) (DEPUTY)

FILED 11-7-85
 BAKER COUNTY SURVEYOR
 SURVEY NO. 7-44-116