


CERTIFIED RECORD OF LAND CORNER MONUMENTATION

Index File Number P-25

History of original corner establishment:

Corner was originally established under G. L. O. contract number 443, by W. B. Barr, during July, 1882. Surveyor General's notes state: "Set post 4 ft. long 4 in. diam, 24 inches in ground for 1/4 sec. corner marked 1/4 S on the west side. from which a Willow 5 ins. diam, bears N40°E, 21 lks. dist. marked 1/4 S BT. An Alder 5 ins. diam, bears N25°W, 32 lks. dist. marked 1/4 S BT."

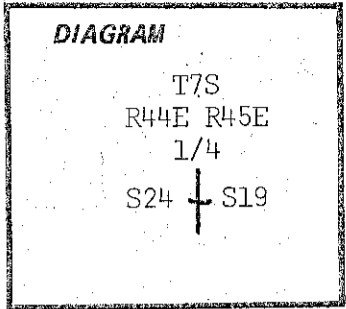


Description of corner evidence found:

Found no trace of record post or bearing trees.

Description of monument and accessories established to perpetuate the original location of this corner:

At surveyed point set 2 1/2" X 30" galvanized pipe and brass cap marked:  
Set pipe 22" in the ground and mound of stone around to cap.

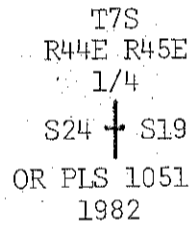

From which by magnetic declination of N20°E:  
A 32" Fir bears N33°E, 73.3 ft. scribed T1S/R45E S19 BT.  
A 32" Fir bears N43°W, 75.5 ft. scribed T1S/R44E S24 BT.  
Painted blazes red and 6" red band around. Placed 54-3s, 54-4s and brass washers stamped PLS 1051 on the bearing trees. Placed 54-4 on a steel fence post 5' north of the corner.

I hereby certify that the above corner monument was reestablished as herein described.

Witnesses: Larry D. Shirley  
Daniel T. Rowland

June 22, 1982.

REGISTERED  
PROFESSIONAL  
LAND SURVEYOR

*Barney B. Barbour*

OREGON  
OCT. 17, 1975  
BARRY B. BARBOUR  
1051

Office of.....County Surveyor..... County of.....Baker.....  
State of.....Oregon....., I hereby certify that the within instrument was filed in this office  
for record on the..... day of....., 1985

..... by .....  
(COUNTY OFFICIAL) (DEPUTY)

FILED 11-7-85  
BAKER COUNTY SURVEYOR  
SURVEY NO. 7-44-117