


CERTIFIED RECORD OF LAND CORNER MONUMENTATION

Index File Number Q-18

History of original corner establishment:

Not Set.

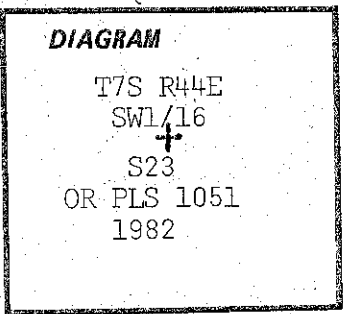

Description of corner evidence found:

None Found.

Description of monument and accessories established to perpetuate the original location of this corner:

At surveyed point set 2 1/2" X 30" galvanized pipe and brass cap marked:
Set pipe 22" in the ground and mound of stone around to cap.

T7S R44E
SW1/16
S23+
OR PLS 1051
1982

From which by magnetic declination of N20°E:
A 12" Fir bears S06°W, 29.5 ft. scribed SW 1/16 S23 BT.
A 16" Fir bears N30°W, 46.2 ft. scribed SW 1/16 S23 BT. Painted blazes red and 6" red band around. Placed 54-3s, 54-9s and brass washers stamped PLS 1051 on the bearing trees. Placed 54-2 and 54-9 on a steel fence post 5' north and placed 54-2 on a steel fence post 5' east of the corner.

I hereby certify that the above corner monument was established as herein described.

Witnesses: Larry D. Shirley
Daniel T. Rowland

June 15, 1982.

REGISTERED
PROFESSIONAL
LAND SURVEYOR

Barry B. Barbour

OREGON
OCT. 17, 1975
BARRY B. BARBOUR
1051

Office of.....County Surveyor..... County of.....Baker.....
State of.....Oregon....., I hereby certify that the within instrument was filed in this office
for record on the..... day of....., 19.85
..... by
(COUNTY OFFICIAL) (DEPUTY)

FILED 11-7-85
BAKER COUNTY SURVEYOR
SURVEY NO. 7-44-118