


CERTIFIED RECORD OF LAND CORNER MONUMENTATION

Index File Number R-11

History of original corner establishment:

Corner was originally established under G. L. O. contract number 503, by W. B. Barr, during August 11, 1884. Surveyor General's notes state: Set basalt rock 12 X 10 X 5 ins., 8 inches in ground for 1/4 sec. cor. marked 1/4 on the N. side. From which a fir 4 ins. diam. bears N80°E, 101 lks. dist. marked 1/4S BT. A fir 4 ins. diam. bears S12°W, 7 lks. dist. marked 1/4S BT."

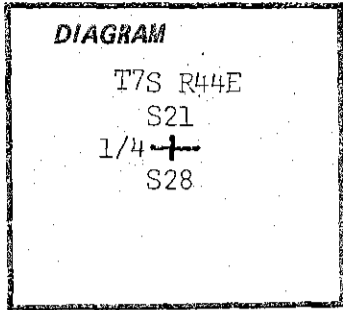

Description of corner evidence found:

Found no trace of record stone or bearing trees. Surveyed point is about 4 chains west of Eagle Creek and not 4.5 chains east as stated in the notes. Both sides of the creek were searched for the original corner.

Description of monument and accessories established to perpetuate the original location of this corner:

At surveyed point set 2 1/2" X 30" aluminum pipe and cap marked:
Set pipe 24" in the ground and mound of stone around to cap.
From which by magnetic declination of N20°E:
A 10" Tamarack bears N26°E, 79.5 ft. scribed 1/4 S21 BT.
An 11" Fir bears S26°E, 17.9 ft. scribed 1/4 S28 BT. Painted blazes red and 6" red band around. Placed 54-3s, 54-4s and brass washers stamped PLS 1051 on the bearing trees. Placed 54-4 on a steel fence post 5' south of the corner.

T7S R44E
S21
1/4 +
S28
OR PLS 1051
1984

I hereby certify that the above corner monument was reestablished as herein described.

Witnesses: Michael E. Marks
Robert W. Wilson

November 7, 1984.

REGISTERED
PROFESSIONAL
LAND SURVEYOR

Barry B. Barbour

OREGON
OCT. 17, 1975
BARRY B. BARBOUR
1051

Office of.....County Surveyor..... County of..... Baker
State of..... Oregon..... I hereby certify that the within instrument was filed in this office
for record on the..... day of....., 19..85
..... by

(COUNTY OFFICIAL)

(DEPUTY)

Form R6-7100-57 (9/71)

☆ U.S. GOVERNMENT PRINTING OFFICE - 1983-793-276

FILED 11-7-85
BAKER COUNTY SURVEYOR
SURVEY NO. 7-44-122