


CERTIFIED RECORD OF LAND CORNER MONUMENTATION

Index File Number R-13

History of original corner establishment:

Corner was originally established under G. L. O. contract number 503, by W. B. Barr, during August 9, 1884. Surveyor General's notes state: "Set post 4 ft. long, 4 ins. diam., 24 ins. in ground for cor. to secs. 21, 22, 27 & 28, marked, from which a pine 20 ins. diam. bears N45°E, 19 lks. dist. marked T7S R44E S22 BT. A fir 8 ins. diam., bears S62°E, 30 lks. dist. marked T7S R44E S27 BT. A pine 22 ins. diam. bears S32°W, 47 lks. dist. marked T7S R44E S28 BT. A pine 25 ins. diam., bears N34°W, 60 lks. dist. marked T7S R44E S21 BT."

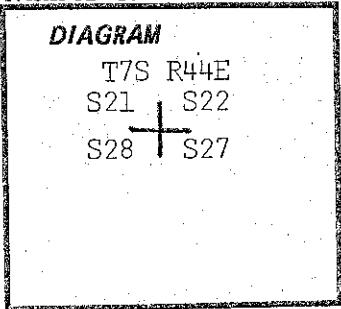


Description of corner evidence found:

Found no trace of record post or bearing trees. The surveyed position falls about 25 ft. west of a road. The area has been logged.

Description of monument and accessories established to perpetuate the original location of this corner:

At surveyed point set 2 1/2" X 30" aluminum pipe and cap marked:
Set pipe 22" in the ground and mound of stone around to cap.

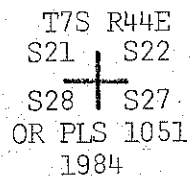

From which by magnetic declination of N20°E:
A 12" Pine bears N09°E, 15.5 ft. scribed T7S R44E S22 BT.
A 16" Fir bears S57°E, 84.0 ft. scribed T7S R44E S27 BT. An 18" Pine bears S50°W, 101.8 ft. scribed T7S R44E S28 BT. A 16" Pine bears N53°W, 59.6 ft. scribed T7S R44E S21 BT. Painted blazes red and 6" red band around. Placed 54-3s, 54-4s and brass washers stamped PLS 1051 on the bearing trees. Placed 54-4 on a steel fence post 5' north of the corner.

I hereby certify that the above corner monument was reestablished as herein described.

Witnesses: Michael E. Marks
Robert W. Wilson

November 7, 1984.

REGISTERED
PROFESSIONAL
LAND SURVEYOR

Barry B. Barbour

OREGON
OCT. 17, 1975
BARRY B. BARBOUR
1051

Office of..... County Surveyor..... County of..... Baker
State of..... Oregon..... I hereby certify that the within instrument was filed in this office
for record on the..... day of....., 19.84

..... by
(COUNTY OFFICIAL) (DEPUTY)

FILED 11-7-85
BAKER COUNTY SURVEYOR
SURVEY NO. 7-44-123