


CERTIFIED RECORD OF LAND CORNER MONUMENTATION

Index File Number R-15

History of original corner establishment:

Corner was originally established under G. L. O. contract number 503, by W. B. Barr, during August 9, 1884. Surveyor General's notes state: "Set basalt rock 16 X 11 X 11 inches, 11 inches in ground for 1/4 sec. cor. marked 1/4 on N. side. From which a pine 30 ins. diam. bears S30°E, 150 lks. dist. marked 1/4S BT. A fir 30 ins. diam. bears N32°W, 135 lks. dist. marked 1/4S BT."

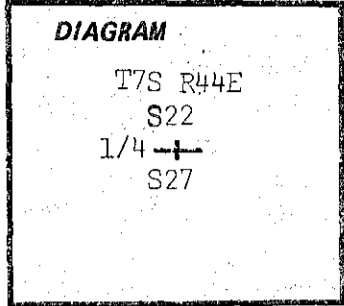

Description of corner evidence found:

Found no trace of record stone or bearing trees. The area of this corner is on a mostly bare west slope. Every large tree, snag and stump within several hundred feet were checked for scribing.

Description of monument and accessories I established to perpetuate the original location of this corner:

At surveyed point set 2 1/2" X 30" aluminum pipe and cap marked:  
 Set pipe 22" in the ground and mound of stone around to cap.  
 From which by magnetic declination of N20°E:  
 A 30" Fir bears N67°W, 248.2 ft. scribed 1/4 S22 BT.  
 A 14" Fir bears N56°W, 264.8 ft. scribed 1/4 S22 BT. No trees available in the south section. Painted blazes red and 6" red band around. Placed 54-3s, 54-4s and brass washers stamped PLS 1051 on the bearing trees. Placed 54-4 on a steel fence post 5' north of the corner.

T7S R44E  
 S22  
 1/4 +  
 S27  
 OR PLS 1051  
 1984

I hereby certify that the above corner monument was reestablished as herein described.

Witnesses: Michael E. Marks  
 Robert W. Wilson

November 2, 1984.

REGISTERED  
 PROFESSIONAL  
 LAND SURVEYOR

*Barry B. Barbour*

OREGON  
 OCT. 17, 1975  
 BARRY B. BARBOUR  
 1051

Office of.....County Surveyor..... County of..... Baker

State of.....Oregon..... I hereby certify that the within instrument was filed in this office for record on the..... day of....., 1985.

..... by .....  
 (COUNTY OFFICIAL) (DEPUTY)

FILED 11-7-85  
 BAKER COUNTY SURVEYOR  
 SURVEY NO. 7-44-124