


CERTIFIED RECORD OF LAND CORNER MONUMENTATION

Index File Number R-20

History of original corner establishment:

Not Set.

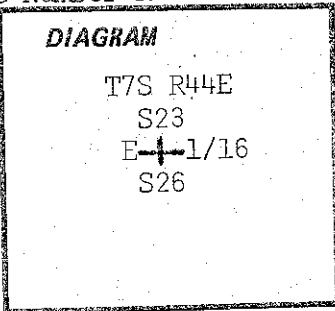

Description of corner evidence found:

None Found.

Description of monument and accessories established to perpetuate the original location of this corner:

At surveyed point set 2 1/2" X 30" galvanized pipe and brass cap marked:
Set pipe 10" in the ground and mound of stone around to cap.

T7S R44E
S23
E $\frac{1}{16}$
S26
OR PLS 1051
1982

From which by magnetic declination of N20°E:
An 18" Pine bears N60°E, 61.4 ft. scribed E1/16 S23 BT.
A 16" Pine bears S47°W, 110.1 ft. scribed E1/16 S26 BT. Painted blazes red and 6" red band around. Placed 54-3s, 54-9s and brass washers stamped PLS 1051 on the bearing trees. Placed 54-2 and 54-9 on a steel fence post 5' north and placed 54-2 on a steel fence post 5' west of the corner.

I hereby certify that the above corner monument was established as herein described.

Witnesses: Larry D. Shirley
Daniel T. Rowland

June 21, 1982.

REGISTERED
PROFESSIONAL
LAND SURVEYOR

Barry B. Barbour

OREGON
OCT. 17, 1975
BARRY B. BARBOUR
1051

Office of.....County..Surveyor..... County of...Baker.....
State of.....Oregon....., I hereby certify that the within instrument was filed in this office
for record on the..... day of....., 19..85
..... by
(COUNTY OFFICIAL) (DEPUTY)

FILED 11-7-85
BAKER COUNTY SURVEYOR
SURVEY NO. 7-44-125