


CERTIFIED RECORD OF LAND CORNER MONUMENTATION

Index File Number R-21

History of original corner establishment:

Corner was originally established under G. L. O. contract number 503, by W. B. Barr, on July 31, 1884. Surveyor General's notes state: "Set sandstone 12 X 12 X 11 ins. 8 inches in ground for cor. to secs. 23, 24, 25 & 26, marked with 2 notches on the S. and 1 notch on the E. edges, raised mound of rock alongside. Pits impracticable."

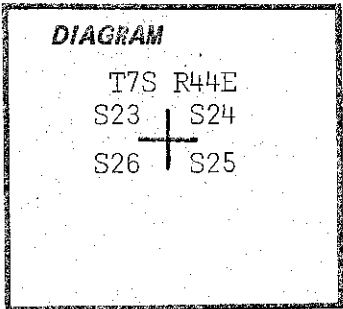


Description of corner evidence found:

Found rough unmarked 12 X 12 X 10 inch lava stone on east side of mound of stone. Could not find any notches. Position checked with corners in four directions.

Description of monument and accessories I established to perpetuate the original location of this corner:

At center of the above stone, set 2 1/2" X 30" galvanized pipe and brass cap marked: Set pipe 12" in the ground to bedrock, and mound of stone around to cap.

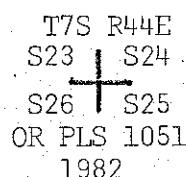

From which by magnetic declination of N20°E: A 16" Pine bears N69°E, 103.7 ft. scribed T7S R44E S24 BT. A 15" Pine bears S68°E, 138.8 ft. scribed T7S R44E S25 BT. A 12" Pine bears S63 1/2°W, 201.7 ft. scribed T7S R44E S26 BT. A 24" Pine bears N36°W, 46.9 ft. scribed T7S R44E S23 BT. Bearing trees were turned and measured with T-2 and EDM. Painted blazes red and 6" red band around. Placed 54-3s, 54-4s and brass washers stamped PLS 1051 on the bearing trees. Placed 54-2 on a steel fence post 5' north and placed 54-2 and 54-4 on a steel post 5' south of the corner.

I hereby certify that the above corner monument was reestablished as herein described.

Witnesses: Larry D. Shirley Daniel T. Rowland

June 22, 1982.

REGISTERED PROFESSIONAL LAND SURVEYOR

Barry B. Barbour

OREGON OCT. 17, 1975 BARRY B. BARBOUR 1051

Office of... County Surveyor... County of... Baker Oregon... State of... I hereby certify that the within instrument was filed in this office for record on the... day of... 1985.

by (COUNTY OFFICIAL) (DEPUTY)

FILED 11-7-85 BAKER COUNTY SURVEYOR SURVEY NO. 7-44-126