


CERTIFIED RECORD OF LAND CORNER MONUMENTATION

Index File Number R-22

History of original corner establishment:

Not Set.

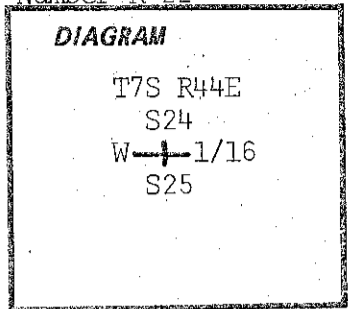

Description of corner evidence found:

None Found.

Description of monument and accessories I established to perpetuate the original location of this corner:

At surveyed point set 2 1/2" X 30" galvanized pipe and brass cap marked:  
Set pipe 25" in the ground and mound of stone around to cap.

From which by magnetic declination of N20°E:

A 15" Fir bears N40°E, 26.7 ft. scribed W1/16 S24 BT.

A 9" Pine bears S71°W, 26.9 ft. scribed W1/16 S25 BT. Painted blazes red and 6" red band around. Placed 54-3s, 54-9s and brass washers stamped PLS 1051 on the bearing trees. Placed 54-2 and 54-9 on a steel fence post 5' north and placed 54-2 on a steel fence post 5' east of the corner.

T7S R44E  
 S24  
 W  $\perp$  1/16  
 S25  
 OR PLS 1051  
 1982

I hereby certify that the above corner monument was established as herein described.

Witnesses: Larry D. Shirley  
 Daniel T. Rowland

July 7, 1982.

REGISTERED  
 PROFESSIONAL  
 LAND SURVEYOR

*Barry B. Barbour*

OREGON  
 OCT. 17, 1975  
 BARRY B. BARBOUR  
 1051

Office of..... County Surveyor..... County of..... Baker  
 Oregon  
 State of....., I hereby certify that the within instrument was filed in this office  
 for record on the..... day of....., 19.85

..... by .....  
 (COUNTY OFFICIAL) (DEPUTY)

FILED 11-7-85  
 BAKER COUNTY SURVEYOR  
 SURVEY NO. 7-44-127