


CERTIFIED RECORD OF LAND CORNER MONUMENTATION

Index File Number T-11

History of original corner establishment:

Not Set.

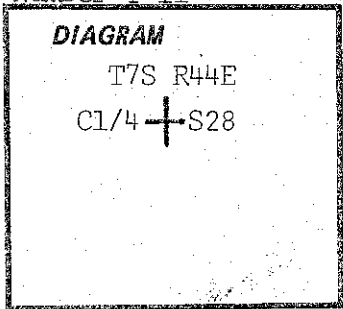

Description of corner evidence found:

None Found.

Description of monument and accessories established to perpetuate the original location of this corner:

At surveyed point set 2 1/2" X 30" aluminum pipe and cap marked:

Set pipe 22" in the ground, No rock in the area. From which by magnetic declination of N20°E:

A 10" Fir bears N18 1/2°E, 9,0 ft. scribed C1/4 S28 BT.

A 12" Fir bears S05 1/2°W, 25.3 ft. scribed C1/4 S28 BT. Painted blazes red and 6" red band around. Placed 54-3s, 54-9s and brass washers stamped PLS 1051 on the bearing trees. Placed 54-9 on a steel fence post 5' north of the corner.

T7S R44E  
C1/4 + S28  
OR PLS 1051  
1984

I hereby certify that the above corner monument was established as herein described.

Witnesses: Michael E. Marks  
Robert W. Wilson

November 7, 1984.

REGISTERED  
PROFESSIONAL  
LAND SURVEYOR

*Barry B. Barbour*

OREGON  
OCT. 17, 1975  
BARRY B. BARBOUR  
1051

Office of.....County Surveyor..... County of.....Baker.....  
State of.....Oregon....., I hereby certify that the within instrument was filed in this office  
for record on the..... day of....., 19.85

..... by .....  
(COUNTY OFFICIAL) (DEPUTY)

FILED 11-7-85

BAKER COUNTY SURVEYOR

SURVEY NO. 7-44-128