


CERTIFIED RECORD OF LAND CORNER MONUMENTATION

Index File Number T-21

History of original corner establishment:

Corner was originally established under G. L. O. contract number 503, by W. B. Barr, on July 31, 1884. Surveyor General's notes state: "Set volcanic rock 12 X 12 X 11 ins. 8 inches in ground for 1/4 sec. cor. marked 1/4 on W. side. Raised mound of rock alongside. Pits impracticable."

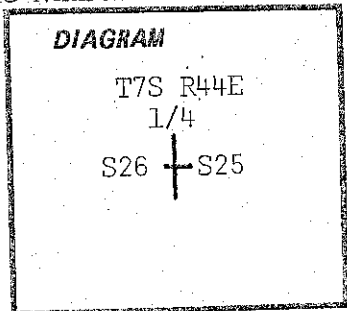

Description of corner evidence found:

Found no trace of record stone or mound. Corner falls on steep east slope.

Description of monument and accessories established to perpetuate the original location of this corner:

At surveyed point set 2 1/2" X 30" galvanized pipe and brass cap marked:
Set pipe 25" in the ground and mound of stone around to cap.

From which by magnetic declination of N20°E:
A 14" Pine bears S23°E, 64.5 ft. scribed 1/4 S25 BT.
A 16" Fir bears N59°W, 24.5 ft. scribed 1/4 S26 BT. Painted blazes red and 6" red band around. Placed 54-3s, 54-4 and brass washers stamped PLS 1051 on the bearing trees. Placed 54-2 and 54-4 on a steel fence post 5' north and placed 54-2 on a steel fence post 5' south of the corner.

T7S R44E
1/4
S26 + S25
OR PLS 1051
1982

I hereby certify that the above corner monument was reestablished as herein described.

Witnesses: Larry D. Shirley
Daniel T. Rowland

June 29, 1982.

REGISTERED
PROFESSIONAL
LAND SURVEYOR

Barry B. Barbour

OREGON
OCT. 17, 1975
BARRY B. BARBOUR
1051

Office of.....County Surveyor..... County of..... Baker
State of..... Oregon....., I hereby certify that the within instrument was filed in this office
for record on the..... day of....., 19..85
..... by
(COUNTY OFFICIAL) (DEPUTY)

FILED 11-7-85
BAKER COUNTY SURVEYOR
SURVEY NO. 7-44-132