


CERTIFIED RECORD OF LAND CORNER MONUMENTATION

Index File Number V-13

History of original corner establishment:

Corner was originally established under G. L. O. contract number 503, by W. B. Barr, during August 7, 1884. Surveyor General's notes state: "Set basalt rock 14 X 9 X 6 ins. 10 inches in ground for cor. to secs. 27, 28 33 & 34, marked with 3 notches on the E. and 1 notch on the S. edges. From which a fir 6 ins. diam. bears N27°E, 36 lks. dist. marked T7S R44E S27 BT. A fir 4 ins. diam. bears N21°W, 20 lks. dist. marked T7S R44E S28 BT. A tamarack 4 ins. diam. bears S16°E, 8 lks. dist. marked T7S R44E S34 BT. A tamarack 4 ins. diam. bears S36°W, 32 lks. dist. marked T7S R44E S33 BT."

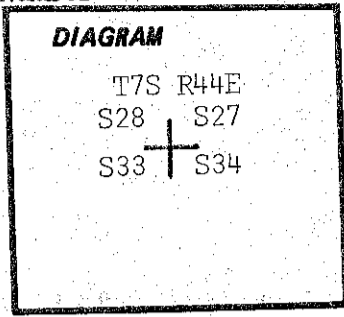


Description of corner evidence found:

Found no trace of record stone or bearing trees. A Mr. Rose sat a corner in 1942, that is about 190 feet to the north. This corner has a marked stone and 4 bearing trees. One of the trees was opened and the ring count shows that the tree was scribed about 40 years ago.

Description of monument and accessories established to perpetuate the original location of this corner:

At surveyed point, corner is below the high water mark of the east side of Eagle Creek. Set witness corner on line towards 1/4 corner, 34.00 feet east of surveyed point. At witness corner set 2 1/2" X 30" aluminum pipe and cap marked: Set pipe 24" in the ground and mound of stone around to cap.

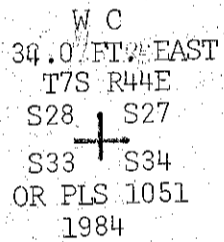

From which by magnetic declination of N20°E: A 15" Pine bears N14°E, 19.2 ft. scribed T7S R44E WC S27 BT. A 15" Fir bears S48°E, 24.1 ft. scribed T7S R44E WC S34 BT. A 14" Tamarack bears S48°W, 18.3 ft. scribed T7S R44E WC S33 BT. A 15" Tamarack bears N52°W, 7.3 ft. scribed T7S R44E WC S28 BT. Painted blazes red and 6" red band around. Placed 54-3s, 54-4s and brass washers stamped PLS 1051 on the bearing trees. Placed 54-4 on a steel fence post 5' west of the corner.

I hereby certify that the above corner monument was reestablished as herein described.

Witnesses: Michael E. Marks
Robert W. Wilson

October 17, 1984.

REGISTERED
PROFESSIONAL
LAND SURVEYOR

Barry B. Barbour

OREGON
OCT. 17, 1975
BARRY B. BARBOUR
1051

Office of.....County.....Surveyor..... County of.....Baker.....
State of.....Oregon....., I hereby certify that the within instrument was filed in this office
for record on the..... day of....., 1985
..... by
(COUNTY OFFICIAL) (DEPUTY)