


CERTIFIED RECORD OF LAND CORNER MONUMENTATION

Index File Number V-14

History of original corner establishment:

Not Set.

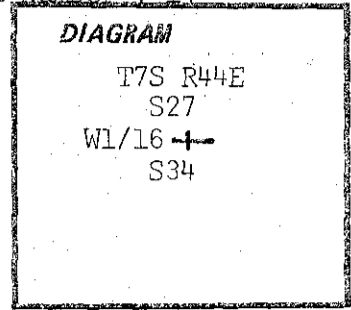

Description of corner evidence found:

None Found.

Description of monument and accessories I established to perpetuate the original location of this corner:

At surveyed point set 2 1/2" X 30" aluminum pipe and cap marked:

Set pipe 24" in the ground.

From which by magnetic declination of N20°E:

An 18" Pine bears S74°W, 141.5 ft. scribed W1/16 S34 BT.

A 15" Pine bears N06°E, 13.4 ft. scribed W1/16 S27 BT.

Painted blazes red and 6" red band around. Placed 54-3s, 54-9s and brass washers stamped PLS 1051 on the bearing trees. Placed 54-9 on a steel fence post 5' west of the corner.

T7S R44E  
S27  
W1/16  $\leftarrow$   
S34  
OR PLS 1051  
1984

I hereby certify that the above corner monument was established as herein described.

Witnesses: Michael E. Marks  
Robert W. Wilson

October 16, 1984.

REGISTERED  
PROFESSIONAL  
LAND SURVEYOR

*Barry B. Barbour*

OREGON  
OCT. 17, 1975  
BARRY B. BARBOUR  
1051

Office of.....County Surveyor..... County of..... Baker.....

State of..... Oregon..... I hereby certify that the within instrument was filed in this office

for record on the..... day of....., 19.85

..... by .....

(COUNTY OFFICIAL)

(DEPUTY)

Form R6-7100-57 (9/71)

☆ U.S. GOVERNMENT PRINTING OFFICE - 1983-793-276

FILED 11-7-85

BAKER COUNTY SURVEYOR

SURVEY NO. 7-44-143