


CERTIFIED RECORD OF LAND CORNER MONUMENTATION

Index File Number V-15

History of original corner establishment:

Corner was originally established under G. L. O. contract number 503, by W. B. Barr, during August 4, 1884. Surveyor General's notes state: "Set granite rock 16 X 11 X 11 ins. 10 inches in ground for 1/4 sec. cor. marked 1/4 on N. side. Raised mound of rock alongside. Pits impracticable."

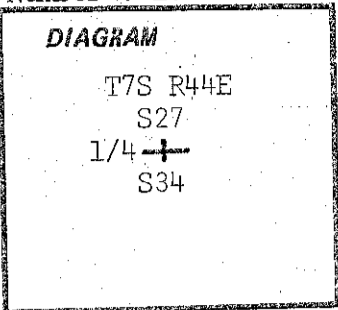

Description of corner evidence found:

Found no trace of record stone or mound. The corner falls on a steep west slope with lots of basalt rock. Part of the search was based on Rose's measurements.

Description of monument and accessories established to perpetuate the original location of this corner:

At surveyed point set 2 1/2" X 30" galvanized pipe and brass cap marked:  
 Set pipe 24" in the ground and mound of stone around to cap.  
 No trees within several hundred feet.  
 Built mound of stone 3 feet high and 3 feet in diameter, 5 feet west of the corner. Placed 54-4 on a steel fence post 5' east of the corner.

T7S R44E  
 S27  
 1/4 ~~+~~  
 S34  
 OR PLS 1051  
 1984

I hereby certify that the above corner monument was reestablished as herein described.

Witnesses: Michael E. Marks  
Robert W. Wilson

October 16, 1984.

REGISTERED  
 PROFESSIONAL  
 LAND SURVEYOR

*Barry B. Barbour*

OREGON  
 OCT. 17, 1975  
 BARRY B. BARBOUR  
 1051

Office of.....County Surveyor..... County of.....Baker.....  
 State of.....Oregon....., I hereby certify that the within instrument was filed in this office  
 for record on the..... day of....., 1985

..... by .....  
 (COUNTY OFFICIAL) (DEPUTY)

FILED 11-7-85  
 BAKER COUNTY SURVEYOR  
 SURVEY NO. 7-44-144