


CERTIFIED RECORD OF LAND CORNER MONUMENTATION

Index File Number V-17

History of original corner establishment:

Corner was originally established under G. L. O. contract number 503, by W. B. Barr, during August 4, 1884. Surveyor General's notes state: "Set basalt rock 15 X 12 X 7 ins., 10 inches in ground for cor. to secs. 26, 27, 34 & 35, marked with 2 notches on the E. and 1 notch on the S. edges. Raised mound of rock alongside. Pits impracticable."

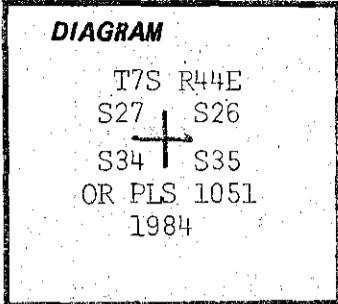


Description of corner evidence found:

Found no trace of record stone or mound. A large area to the west was searched for this corner.

Description of monument and accessories established to perpetuate the original location of this corner:

At surveyed point set 2 1/2" X 30" aluminum pipe and cap marked:
Set pipe 24" in the ground and mound of stone around to cap.

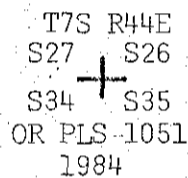

From which by magnetic declination of N20°E:
A 16" Pine bears N30 1/2°E, 95.9 ft. scribed T7S R44E S26 BT. A 6" Pine bears S01°W, 33.6 ft. scribed T7S R44E S35 BT. A 6" Pine bears N87°W, 27.4 ft. scribed T7S R44E S34 BT. An 18" Fir bears N10°W, 120.2 ft. scribed T7S R44E S27 BT. Painted blazes red and 6" red band around. Placed 54-3s, 54-4s and brass washers stamped PLS 1051 on the bearing trees. Placed 54-4 on a steel fence post 5' east of the corner.

I hereby certify that the above corner monument was reestablished as herein described.

Witnesses: Michael E. Marks
Robert W. Wilson

November 1, 1984.

REGISTERED
PROFESSIONAL
LAND SURVEYOR

Barry B. Barbour
OREGON
OCT. 17, 1975
BARRY B. BARBOUR
1051

Office of.....County Surveyor..... County of.....Baker.....

State of.....Oregon..... I hereby certify that the within instrument was filed in this office

for record on the..... day of....., 19..85

..... by

(COUNTY OFFICIAL)

(DEPUTY)

Form R6-7100-57 (9/71)

☆U.S. GOVERNMENT PRINTING OFFICE • 1983-793-276

FILED 11-7-85
BAKER COUNTY SURVEYOR
SURVEY NO. 7-44-145