


CERTIFIED RECORD OF LAND CORNER MONUMENTATION

Index File Number V-19

History of original corner establishment:

Corner was originally established under G. L. O. contract number 503, by W. B. Barr, during August 5, 1884. Surveyor General's notes state: "Set granite rock 16 X 10 X 8 ins. 11 inches in ground for 1/4 sec. cor. marked 1/4 on N. side. From which a pine 30 ins. diam. bears N30°E, 58 lks. dist. marked 1/4S BT. A pine 20 ins. diam. bears S65°W, 60 lks. dist. marked 1/4S BT."

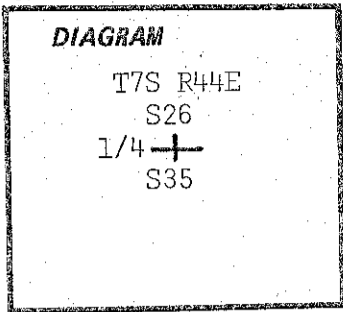

Description of corner evidence found:

Found no trace of record post or bearing trees. The area has been logged.

Description of monument and accessories I established to perpetuate the original location of this corner:

At surveyed point set 2 1/2" X 30" galvanized pipe and brass cap marked:


Set pipe 24" in the ground. No rock in the area.

From which by magnetic declination of N20°E:

A 12" Pine bears S29°W, 33.6 ft. scribed 1/4 S35 BT.

A 10" Pine bears N45°W, 18.4 ft. scribed 1/4 S26 BT.

Painted blazes red and 6" red band around. Placed 54-3s, 54-4s and brass washers stamped PLS 1051 on the bearing trees. Placed 54-2 and 54-4 on a steel fence post 5' south and placed 54-2 on a steel fence post 5' north of the corner.

T7S R44E  
S26  
1/4   
S35  
OR PLS 1051  
1984

I hereby certify that the above corner monument was reestablished as herein described.

Witnesses: Michael E. Marks  
Robert W. Wilson

September 17, 1984.

REGISTERED  
PROFESSIONAL  
LAND SURVEYOR

*Barry B. Barbour*

OREGON  
OCT. 17. 1975  
BARRY B. BARBOUR  
1 0 5 1

Office of.....County Surveyor..... County of..... Baker.....  
State of..... Oregon....., I hereby certify that the within instrument was filed in this office  
for record on the..... day of....., 1985.

..... by .....  
(COUNTY OFFICIAL) (DEPUTY)

FILED 11-7-85  
BAKER COUNTY SURVEYOR  
SURVEY NO. 7-44-146