


CERTIFIED RECORD OF LAND CORNER MONUMENTATION

Index File Number V-23

History of original corner establishment:

Corner was originally established under G. L. O. contract number 503, by W. B. Barr, on July 31, 1884. Surveyor General's notes state: "Set sandstone 16 X 12 X 10 ins. 11 inches in ground for 1/4 sec. cor. marked 1/4 on N. side. Raised mound of rock alongside. Pit impracticable."

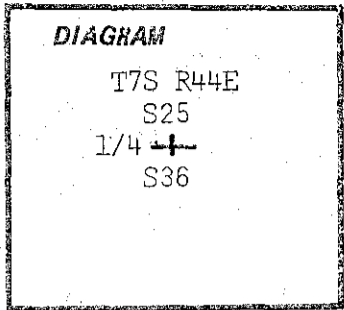

Description of corner evidence found:

Found no trace of record stone or mound of stone. Corner falls on rocky west slope and there are several skid roads in the area. No large trees or stumps near this area. Area has been searched by others, as lots of rocks have been turned over.

Description of monument and accessories established to perpetuate the original location of this corner:

At surveyed point set 2 1/2" X 30" galvanized pipe and brass cap marked:  
Set pipe 24" in the ground and mound of stone around to cap.

T7S R44E  
S25  
1/4 +  
S36  
OR PLS 1051  
1982

From which by magnetic declination of N20°E:  
A 16" Pine bears N21°E, 28.7 ft. scribed 1/4 S25 BT.  
A 20" Pine bears S26°E, 5.6 ft. scribed 1/4 S36 BT. Painted blazes red and 6" red band around. Placed 54-3s, 54-4s and brass washers stamped PLS 1051 on the bearing trees. Placed 54-2 and 54-4 on a steel fence post 5' east and placed 54-2 on a steel fence post 5' west of the corner.

I hereby certify that the above corner monument was reestablished as herein described.

Witnesses: Larry D. Shirley  
Daniel T. Rowland

July 12, 1982.

REGISTERED  
PROFESSIONAL  
LAND SURVEYOR

*Barry B. Barbour*

OREGON  
OCT. 17, 1975  
BARRY B. BARBOUR  
1051

Office of.....County Surveyor..... County of.....Baker.....

State of.....Oregon..... I hereby certify that the within instrument was filed in this office

for record on this..... day of....., 19..85

..... by .....  
(COUNTY OFFICIAL) (DEPUTY)

FILED 11-7-85  
BAKER COUNTY SURVEYOR  
SURVEY NO. 7-44-148