


CERTIFIED RECORD OF LAND CORNER MONUMENTATION

Index File Number W-19

History of original corner establishment:

Not Set.

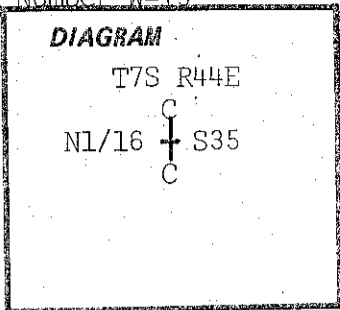

Description of corner evidence found:

None Found.

Description of monument and accessories I established to perpetuate the original location of this corner:

At surveyed point set 2 1/2" X 30" galvanized pipe and brass cap marked:

Set pipe 24" in the ground. No rock in the area.

From which by magnetic declination of N20°E:

An 8" Pine bears S50°E, 18.2 ft. scribed CN 1/16 S35 BT.

A 14" Pine bears N60°W, 22.0 ft. scribed CN 1/16 S35 BT.

Painted blazes red and 6" red band around. Placed 54-3s, 54-9s and brass washers stamped PLS 1051 on the bearing trees. Placed 54-2 and 54-9 on a steel fence post 5' north and placed 54-2 on a steel fence post 5' east of the corner.

T7S R44E	
C	+
NL/16	S35
C	C
OR PLS 1051	
1984	

I hereby certify that the above corner monument was established as herein described.

Witnesses: Michael E. Marks  
Robert W. Wilson

September 17, 1984.

REGISTERED  
PROFESSIONAL  
LAND SURVEYOR

*Barry B. Barbour*

OREGON  
OCT. 17, 1975  
BARRY B. BARBOUR  
1051

Office of..... County Surveyor..... County of..... Baker  
State of..... Oregon....., I hereby certify that the within instrument was filed in this office  
for record on the..... day of....., 1985.

..... by .....  
(COUNTY OFFICIAL) (DEPUTY)

FILED 11-7-85  
BAKER COUNTY SURVEYOR  
SURVEY NO. 7-44-156