


**CERTIFIED RECORD OF LAND CORNER MONUMENTATION**

Index File Number W-23

**History of original corner establishment:**

Not Set.

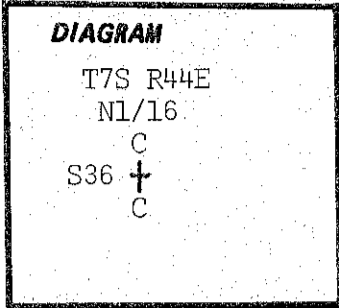

**Description of corner evidence found:**

None Found.

**Description of monument and accessories established to perpetuate the original location of this corner:**

At surveyed point set 2 1/2" X 30" galvanized pipe and brass cap marked:  
 Set pipe 26" in the ground and mound of stone around to cap.

T7S R44E  
 N1/16  
 C  
 S36 +  
 C  
 OR PLS 1051  
 1983

From which by magnetic declination of N20°E:  
 An 8" Pine bears S14°E, 82.0 ft. scribed CN 1/16 S36 BT.  
 A 15" Pine bears S61°W, 45.8 ft. scribed CN 1/16 S36 BT.  
 Painted blazes red and 6" red band around. Placed 54-3s, 54-9s and brass washers stamped PLS 1051 on the bearing trees. Placed 54-2 and 54-9 on a steel fence post 5' east and placed 54-2 on a steel fence post 5' south of the corner.

I hereby certify that the above corner monument was established as herein described.

Witnesses: Larry D. Shirley  
 Troy A. Slobig

November 8, 1983.

REGISTERED  
 PROFESSIONAL  
 LAND SURVEYOR

*Barry B. Barbour*

OREGON  
 OCT. 17, 1975  
 BARRY B. BARBOUR  
 1051

Office of..... County Surveyor..... County of..... Baker.....  
 State of..... Oregon..... I hereby certify that the within instrument was filed in this office  
 for record on the..... day of....., 1985  
 ..... by .....  
 (COUNTY OFFICIAL) (DEPUTY)