


CERTIFIED RECORD OF LAND CORNER MONUMENTATION

Index File Number X-11

History of original corner establishment:

Not set.

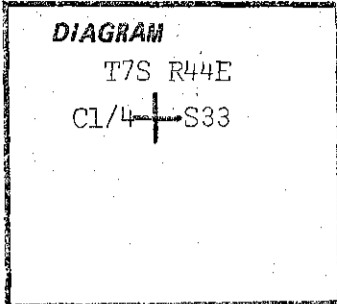

Description of corner evidence found:

None Found.

Description of monument and accessories established to perpetuate the original location of this corner:

At surveyed point set 2 1/2" X 30" aluminum pipe and cap marked:  
Set pipe 24" in the ground and mound of stone around to cap.

T7S R44E  
C1/4 + S33  
OR PLS 1051  
1984

From which by magnetic declination of N20°E:  
A 10" Fir bears S88°E, 35.8 ft. scribed C1/4 S33 BT. A 12" Pine bears N35°W, 43.5 ft. scribed C1/4 S33 BT. Painted blazes red and 6" red band around. Placed 54-3s, 54-9s and brass washers stamped PLS 1051 on the bearing trees. Placed 54-2 and 54-9 on a steel fence post 5' north and 54-2 on a steel fence post 5' south of the corner.

I hereby certify that the above corner monument was established as herein described.

Witnesses: Michael E. Marks  
Robert W. Wilson

November 16, 1984

REGISTERED  
PROFESSIONAL  
LAND SURVEYOR

*Barry B. Barbour*

OREGON  
OCT. 17, 1975  
BARRY B. BARBOUR  
1051

Office of.....County..Surveyor..... County of.....Baker.....

State of.....Oregon..... I hereby certify that the within instrument was filed in this office for record on the..... day of....., 1985.

..... by .....  
(COUNTY OFFICIAL) (DEPUTY)

Form R6-7100-57 (9/71)

☆ U.S. GOVERNMENT PRINTING OFFICE - 1983-793-276

FILED 11-7-85  
BAKER COUNTY SURVEYOR  
SURVEY NO. 7-44-161