


CERTIFIED RECORD OF LAND CORNER MONUMENTATION

Index File Number X-13

History of original corner establishment:

Corner was originally established under G. L. O. contract number 503, by W. B. Barr, during August 9, 1884. Surveyor General's notes state: "Set basalt rock 16 X 11 X 5 ins., 11 inches in ground for 1/4 sec. cor. marked 1/4 on the W. side. From which a fir 4 ins. diam. bears N46°E, 22 lks. dist. marked 1/4S BT. A tamarack 4 ins. diam. bears S25°W, 27 lks. dist. marked 1/4S BT."

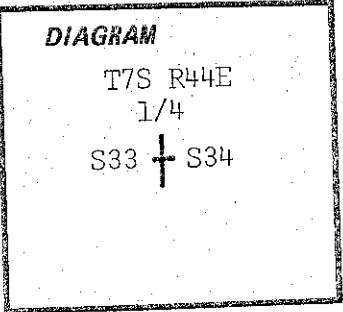

Description of corner evidence found:

Found no trace of original corner evidence. Found mound of stone on a ledge, with a 34" Pine 15' west of the mound and 28" Fir snag, visible scribing, about S45°E, 35 feet, of the mound.

Description of monument and accessories I established to perpetuate the original location of this corner:

At surveyed point set 2 1/2" X 30" aluminum pipe and cap marked:

Set pipe 25" in the ground and mound of stone around to cap.

From which by magnetic declination of N20°E:

A 6" Fir bears S80°E, 7.7 ft. scribed 1/4 S34 BT.

A 7" Fir bears S68°W, 23.6 ft. scribed 1/4 S33 BT. Painted blazes red and 6" red band around. Placed 54-3s, 54-4s and brass washers stamped PLS 1051 on the bearing trees. Placed 54-4 on a steel fence post 5' west of the corner.

T7S R44E  
1/4  
S33 + S34  
OR PLS 1051  
1984

I hereby certify that the above corner monument was reestablished as herein described.

Witnesses: Michael E. Marks  
Robert W. Wilson

November 14, 1984,

REGISTERED  
PROFESSIONAL  
LAND SURVEYOR

*Barry B. Barbour*

OREGON  
OCT. 17, 1975  
BARRY B. BARBOUR  
1051

Office of.....County Surveyor..... County of Baker  
State of Oregon....., I hereby certify that the within instrument was filed in this office  
for record on the..... day of....., 1985.  
..... by .....  
(COUNTY OFFICIAL) (DEPUTY)

FILED 11-7-85  
BAKER COUNTY SURVEYOR  
SURVEY NO. 7-44-163