


CERTIFIED RECORD OF LAND CORNER MONUMENTATION

Index File Number X-16

History of original corner establishment:

Not Set.

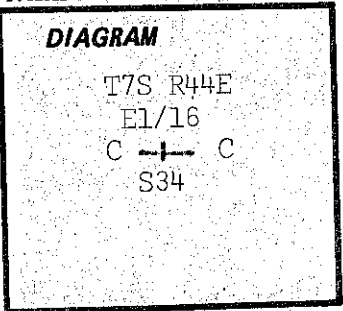

Description of corner evidence found:

None Found.

Description of monument and accessories established to perpetuate the original location of this corner:

At surveyed point set 2 1/2" X 30" aluminum pipe and cap marked:
 Set pipe 25" in the ground and mound of stone around to cap.

T7S R44E
 E1/16
 C —+— C
 S34
 OR PLS 1051
 1984

From which by magnetic declination of N20°E:
 A 12" Pine bears S21°E, 25.0 ft. scribed CE 1/16 S34 BT.
 A 12" Pine bears N70°W, 24.8 ft. scribed CE 1/16 S34 BT. Painted blazes red and 6" red band around. Placed 54-3s, 54-9s and brass washers stamped PLS 1051 on the bearing trees. Placed 54-9 on a steel fence post 5' east of the corner.

I hereby certify that the above corner monument was established as herein described.

Witnesses: Michael E. Marks
Robert W. Wilson

November 1, 1984.

REGISTERED
 PROFESSIONAL
 LAND SURVEYOR

Barry B. Barbour

OREGON
 OCT. 17, 1975
 BARRY B. BARBOUR
 1051

Office of.....County Surveyor..... County of.....Baker.....
 State of.....Oregon..... I hereby certify that the within instrument was filed in this office
 for record on the..... day of....., 1985
 by
 (COUNTY OFFICIAL) (DEPUTY)

Form R6-7100-57 (9/71)

☆ U.S. GOVERNMENT PRINTING OFFICE • 1983-793-276

FILED 11-7-85
 BAKER COUNTY SURVEYOR
 SURVEY NO. 7-44-166