


CERTIFIED RECORD OF LAND CORNER MONUMENTATION

Snow Fork Tract

History of original corner establishment:

Unknown.

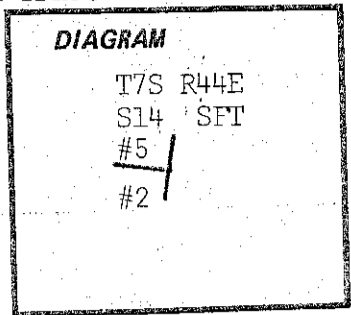

Description of corner evidence found:

Found 6' steel fence post projecting 18" above the ground.

Description of monument and accessories established to perpetuate the original location of this corner:

Surveyed point is marked center of 6' steel fence post.
 Removed fence post and set 2 1/2" X 30" galvanized pipe and brass cap marked;
 Set pipe 24" in the ground and mound of stone around to cap.

T7S R44E
S14 SFT
#5
#2
OR PLS 1051
1982

From which by magnetic declination of N20°E:
 A 20" Fir bears N45°E, 106.1 ft. scribed S14 SFT #2/5 BT.
 An 18" Fir bears N78°E, 151.3 ft. scribed S14 SFT #2/5 BT. Painted blazes red and 6" red band around. Placed 54-8s, 54-9s and brass washers stamped PLS 1051 on the bearing trees. Placed 54-2 and 54-9 on a steel fence post 5' north and placed 54-2 on a steel fence post 5' south of the corner.

I hereby certify that the above corner monument was established as herein described.

Witnesses: Larry D. Shirley
Michael L. Cain

November 15, 1982.

REGISTERED
PROFESSIONAL
LAND SURVEYOR

Barry B. Barbour

OREGON
OCT. 17, 1975
BARRY B. BARBOUR
1051

Office of.....County Surveyor..... County of.....Baker.....
 State of.....Oregon....., I hereby certify that the within instrument was filed in this office
 for record on the..... day of....., 19.85
 by..... (DEPUTY)

FILED 11-7-85
 BAKER COUNTY SURVEYOR
 SURVEY NO. 7-44-179