


CERTIFIED RECORD OF LAND CORNER MONUMENTATION

Snow Fork Tract

History of original corner establishment:

Unknown.

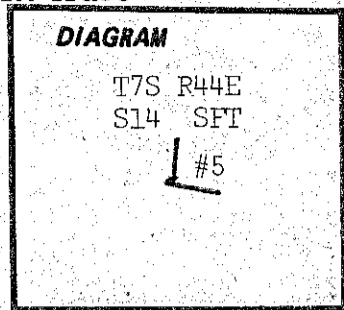

Description of corner evidence found:

Found 6' steel fence post projecting 8" above the ground.

Description of monument and accessories established to perpetuate the original location of this corner:

Surveyed point is marked center of 6' steel fence post.
 Removed fence post and set 2 1/2" X 30" galvanized pipe
 and brass cap marked:
 Set pipe 24" in the ground. No rock in the area.
 From which by magnetic declination of N20°E:
 A 20" Fir bears S49°E, 47.0 ft. scribed S14 SFT #5 BT,
 A 15" Pine bears N-5°W, 19.6 ft. scribed S14 SFT #5 BT. Painted blazes
 red and 6" red band around. Placed 54-8s, 54-9s and brass washers stamped
 PLS 1051 on the bearing trees. Placed 54-2 and 54-9 on a steel fence post,
 N06 1/2°E, 5' and placed 54-2 on a steel fence post, S83 1/2°E, 5' from the
 corner.

T7S R44E
S14 SFT
#5
OR PLS 1051
1982

I hereby certify that the above corner monument was established as herein described.

Witnesses: Larry D. Shirley
Michael L. Cain

November 16, 1982.

REGISTERED
PROFESSIONAL
LAND SURVEYOR

Barry B. Barbour

OREGON
OCT. 17, 1975
BARRY B. BARBOUR
1051

Office of.....County Surveyor.....County of...Baker.....
 State of.....Oregon....., I hereby certify that the within instrument was filed in this office
 for record on the..... day of....., 19.85

..... by
 (COUNTY OFFICIAL) (DEPUTY)

Form R6-7100-57 (9/71)

FILED 11-7-85
 BAKER COUNTY SURVEYOR
 SURVEY NO. 7-44-184