


CERTIFIED RECORD OF LAND CORNER MONUMENTATION

Index File Number V-13.25 (+0.50)

History of original corner establishment:

Not Set.

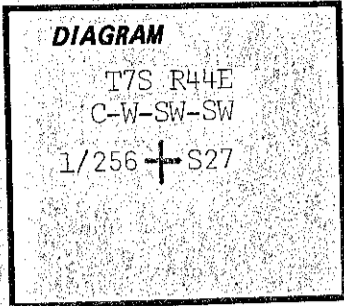

Description of corner evidence found:

None Found.

Description of monument and accessories I established to perpetuate the original location of this corner:

At surveyed point set 2 1/2" X 30" aluminum pipe and cap marked:
 Set pipe 26" in the ground and mound of stone around to cap.
 From which by magnetic declination of N20°E:
 A 20" Pine bears N04°W, 26.3 ft. scribed C/W/SW/SW 1/256 S27 BT.
 A 15" Fir bears S22°W, 175.5 ft. scribed C/W/SW/SW 1/256 S27 BT.
 Painted blazes red and 6" red band around. Placed 54-3s, 54-9s and brass washers stamped PLS 1051 on the bearing trees. Placed 54-2 and 54-9 on a steel fence post 5' south and placed 54-2 on a steel fence post 5' west of the corner.

T7S R44E
C/W/SW/SW
1/256 + S27
OR PLS 1051
1985

I hereby certify that the above corner monument was established as herein described.

Witnesses: Joseph M. Gaarsland
Daniel J. McMillan

June 6, 1985.

REGISTERED
PROFESSIONAL
LAND SURVEYOR

Barry B. Barbour

OREGON
OCT. 17, 1975
BARRY B. BARBOUR
1051

Office of.....County Surveyor.....County of.....Baker.....
 State of.....Oregon..... I hereby certify that the within instrument was filed in this office
 for record on the..... day of....., 19.85
 by
 (COUNTY OFFICIAL) (DEPUTY)