


CERTIFIED RECORD OF LAND CORNER MONUMENTATION

Index File Number V-12.50

History of original corner establishment:

Not Set.

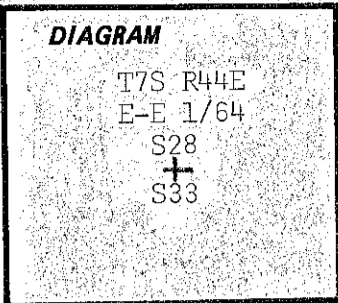

Description of corner evidence found:

None Found.

Description of monument and accessories I established to perpetuate the original location of this corner:

At surveyed point set 2 1/2" X 30" aluminum pipe and cap marked: T7S R44E
 E/E 1/64
 S28
 +
 S33
 From which by magnetic declination of N20°E: OR PLS 1051
 A 10" Fir bears N31°W, 72.9 ft. scribed E/E 1/64 S28 BT. 1985
 A 14" Fir bears S42°E, 19.1 ft. scribed E/E 1/64 S33 BT.
 Painted blazes red and 6" red band around. Placed 54-3s, 54-9s and brass washers stamped PLS 1051 on the bearing trees. Placed 54-2 and 54-9 on a steel fence post 5' north and placed 54-2 on a steel fence post 2' south of the corner.

I hereby certify that the above corner monument was established as herein described.

Witnesses: Joseph M. Gaarsland
Daniel J. McMillan

June 6, 1985.

REGISTERED
 PROFESSIONAL
 LAND SURVEYOR

Barry B. Barbour
 OREGON
 OCT. 17, 1975
 BARRY B. BARBOUR
 1051

Office of.....County Surveyor..... County of.....Baker.....
 State of.....Oregon....., I hereby certify that the within instrument was filed in this office
 for record on the..... day of....., 1985.
 by
 (COUNTY OFFICIAL) (DEPUTY)