


CERTIFIED RECORD OF LAND CORNER MONUMENTATION

Index File Number V-13.25

History of original corner establishment:

Not Set.

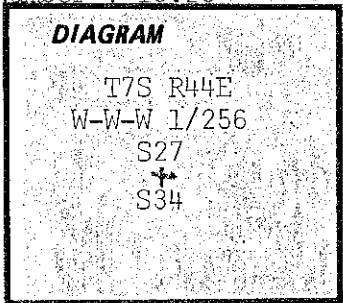

Description of corner evidence found:

None Found.

Description of monument and accessories I established to perpetuate the original location of this corner:

At surveyed point set 2 1/2" X 30" aluminum pipe and cap marked:
Set pipe 22" in the ground and mound of stone around to cap. From which by magnetic declination of N20°E:
A 12" Fir bears N18°E, 61.3 ft. scribed W/W/W 1/256 S27 BT.
A 10" Pine bears S05°E, 55.8 ft. scribed W/W/W 1/256 S34 BT.
Painted blazes red and 6" red band around. Placed 54-3s, 54-9s and brass washers stamped PLS 1051 on the bearing trees. Placed 54-2 and 54-9 on a steel fence post 5' north and placed 54-2 on a steel fence post 5' south of the corner.

T7S R44E
W/W/W 1/256
S27
+
S34
OR PLS 1051
1985

I hereby certify that the above corner monument was established as herein described.

Witnesses: Joseph M. Gaarsland
Daniel J. McMillan

June 6, 1985.

REGISTERED
PROFESSIONAL
LAND SURVEYOR

Barry B. Barbour
OREGON
OCT. 17, 1973
BARRY B. BARBOUR
1051

Office of.....County Surveyor..... County of.....Baker.....
State of.....Oregon....., I hereby certify that the within instrument was filed in this office
for record on the..... day of....., 1985.
..... by
(COUNTY OFFICIAL) (DEPUTY)