


CERTIFIED RECORD OF LAND CORNER MONUMENTATION

Index File Number W-12,50

History of original corner establishment:

Not Set.

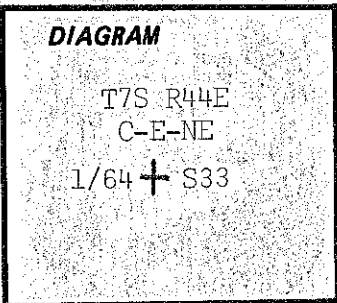

Description of corner evidence found:

None Found.

Description of monument and accessories established to perpetuate the original location of this corner:

At surveyed point set 2 1/2" X 30" aluminum pipe and cap marked: T7S R44E
Set pipe 26" in the ground and mound of stone around to cap. C/E-NE
From which by magnetic declination of N20°E: 1/64 + S33
An 11" Pine bears N87°E, 16.8 ft. scribed C/E/NE 1/64 S33 BT. OR PLS 1051
A 9" Pine bears S47°W, 12.4 ft. scribed C/E/NE 1/64 S33 BT. 1985
Painted blazes red and 6" red band around. Placed 54-3s, 54-9s.
and brass washers stamped PLS 1051 on the bearing trees. Placed 54-2 and
54-9 on a steel fence post 5' north and placed 54-2 on a steel fence post
5' east of the corner.

I hereby certify that the above corner monument was established as herein described.

Witnesses: Joseph M. Gaarsland
Daniel J. McMillan

June 6, 1985.

REGISTERED
PROFESSIONAL
LAND SURVEYOR

Barry B. Barbour
OREGON
OCT. 17, 1975
BARRY B. BARBOUR
1051

Office of.....County Surveyor..... County of..... Baker
State of..... Oregon....., I hereby certify that the within instrument was filed in this office
for record on the..... day of....., 1985.
..... by
(COUNTY OFFICIAL) (DEPUTY)

Form R6-7100-57 (9/71)

FILED 11-7-85
BAKER COUNTY SURVEYOR
SURVEY NO. 7-44-190