


CERTIFIED RECORD OF LAND CORNER MONUMENTATION

Index File Number W-12.75

History of original corner establishment:

Not Set.

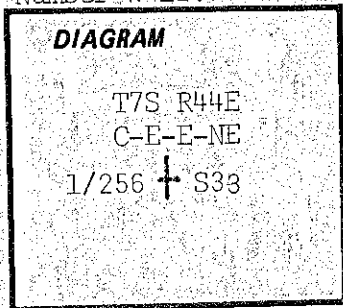

Description of corner evidence found:

None Found.

Description of monument and accessories | established to perpetuate the original location of this corner:

At surveyed point set 2 1/2" X 30" aluminum pipe and cap marked:
 Set pipe 25" in the ground and mound of stone around to cap.
 From which by magnetic declination of N20°E:
 A 10" Fir bears N52°E, 14.6 ft. scribed C/E/E/NE 1/256 S33
 BT. A 6" Fir bears S02°E, 22.9 ft. scribed C/E/E/NE 1/256 S33 BT. Painted blazes red and 6" red band around. Placed 54-3s, 54-9s and brass washers stamped PLS 1051 on the bearing trees. Placed 54-2 and 54-9 on a steel fence post 5' south and placed 54-2 on a steel fence post 5' west of the corner.

T7S R44E
 C/E/E/NE
 1/256 + S33
 OR PLS 1051
 1985

I hereby certify that the above corner monument was established as herein described.

Witnesses: Joseph M. Gaarsland
Daniel J. McMillan

June 4, 1985.

REGISTERED
 PROFESSIONAL
 LAND SURVEYOR

Barry B. Barbour

OREGON
 OCT. 17, 1975
 BARRY B. BARBOUR
 1031

Office of.....County Surveyor..... County of.....Baker.....
 State of.....Oregon..... I hereby certify that the within instrument was filed in this office
 for record on the..... day of....., 19.85
 by
 (COUNTY OFFICIAL) (DEPUTY)