


CERTIFIED RECORD OF LAND CORNER MONUMENTATION

Index File Number W-14 (-0.50)

History of original corner establishment:

Not Set.

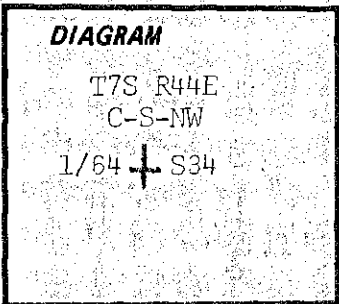

Description of corner evidence found:

None Found.

Corner position is in pond. Set a witness corner N7° 14' 19" E, 95.56 feet.

Description of monument and accessories established to perpetuate the original location of this corner:

At surveyed point set 2 1/2" X 30" aluminum pipe and cap marked:

Set pipe 14" in the ground and mound of stone around to cap.

From which by magnetic declination of N20°E:

A 14" Pine bears S70°E, 28.7 ft. scribed C/S/NW 1/64 S34 BT. 1985

A 12" Pine bears N40°W, 54.0 ft. scribed C/S/NW 1/64 S34 BT.

Painted blazes red and 6" red band around. Placed 54-3s, 54-9s and brass washers stamped PLS 1051 on the bearing trees. Placed 54-2 and 54-9 on a steel fence post 5' north and placed 54-2 on a steel fence post 5' east of the corner.

WC 95.56 FT NO
T7S R44E
C/S/NW
1/64 + S34
OR PLS 1051

I hereby certify that the above corner monument was established as herein described.

Witnesses: Orville G. Allen
Joseph M. Gaarsland

May 20, 1985.

REGISTERED
PROFESSIONAL
LAND SURVEYOR

Barry B. Barbour
OREGON
OCT. 17, 1975
BARRY B. BARBOUR
1051

Office of.....County Surveyor..... County of.....Baker.....

State of.....Oregon....., I hereby certify that the within instrument was filed in this office

for record on the..... day of....., 1985.

..... by
(COUNTY OFFICIAL) (DEPUTY)

Form R6-7100-57 (9/71)

FILED 11-7-85

BAKER COUNTY SURVEYOR

SURVEY NO. 7-44-195

☆ GPO-798-276