


CERTIFIED RECORD OF LAND CORNER MONUMENTATION

12

Index File Number W-14.25 (-0.50)

History of original corner establishment:

Not Set.

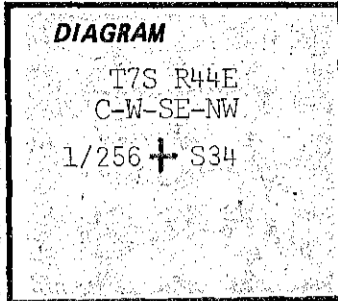

Description of corner evidence found:

None Found.

Description of monument and accessories I established to perpetuate the original location of this corner:

At surveyed point set 2 1/2" X 30" aluminum pipe and cap marked:
 Set pipe 26" in the ground and mound of stone around to cap.
 From which by magnetic delination of N20°E:
 A 10" Pine bears S74°E, 16.2 ft. scribed C/W/SE/NW 1/256 S34
 BT. A 6" Fir bears N44°W, 9.8 ft. scribed C/W/SE/NW 1/256 S34
 BT. Painted blazes red and 6" red band around. Placed 54-3s, 54-9s and brass washers stamped PLS 1051 on the bearing trees. Placed 54-2 and 54-9 on a steel fence post 5' south and placed 54-2 on a steel fence post 5' west of the corner.

T7S R44E
C/W/SE/NW
1/256 + S34
OR PLS 1051
1985

I hereby certify that the above corner monument was established as herein described.

Witnesses: Orville G. Allen
Joseph M. Gaarsland

May 21, 1985.

REGISTERED
PROFESSIONAL
LAND SURVEYOR

Barry B. Barbour
 OREGON
 OCT. 17, 1973
 BARRY B. BARBOUR
 1051

Office of.....County Surveyor..... County of.....Baker.....
 State of.....Oregon..... I hereby certify that the within instrument was filed in this office
 for record on the..... day of....., 19..85
 by
 (COUNTY OFFICIAL) (DEPUTY)

Form R6-7100-57 (9/71)

FILED 11-7-85
 BAKER COUNTY SURVEYOR
 SURVEY NO. 7-44-196

☆ GPO—798-275