


**CERTIFIED RECORD OF LAND CORNER MONUMENTATION**

Index File Number X-13.5 (+0.25)

**History of original corner establishment:**

Not Set.

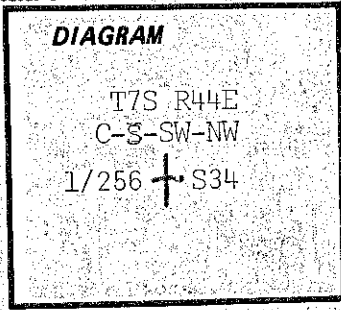

**Description of corner evidence found:**

None Found.

**Description of monument and accessories I established to perpetuate the original location of this corner:**

Surveyed point falls in active slide area. Set fence post at this point with two 54-2s. On a small ridge, that is S63° 55' 00" E, 36.11 ft. set a reference monument. Set pipe 20" in the ground and mound of stone around to cap.

R M  
T7S R44E  
C/S/SW/NW  
1/256 + S34  
OR PLS 1051  
1985

From which by magnetic declination of N20°E:  
An 18" Pine bears S45°E, 14.0 ft. scribed RM C/S/SW/NW 1/256 S34 BT. A 12" Fir bears S44°W, 15.7 ft. scribed RM C/S/SW/NW 1/256 S34 BT. Painted blazes red and 6" red band around. Placed 54-3s, 54-9s and brass washers stamped PLS 1051 on the bearing trees. Placed 54-9 on a steel fence post 5' south of the corner.

I hereby certify that the above corner monument was established as herein described.

Witnesses: Daniel J. McMillan  
John C. Austin

June 14, 1985.

REGISTERED  
PROFESSIONAL  
LAND SURVEYOR

*Barry B. Barbour*

OREGON  
OCT. 17, 1975  
BARRY B. BARBOUR  
1051

Office of.....County Surveyor..... County of.....Baker.....  
State of.....Oregon..... I hereby certify that the within instrument was filed in this office  
for record on the..... day of....., 19.85  
..... by .....  
(COUNTY OFFICIAL) (DEPUTY)

FILED 11-7-85  
BAKER COUNTY SURVEYOR  
SURVEY NO. 7-44-198