


CERTIFIED RECORD OF LAND CORNER MONUMENTATION

Index File Number X-15.25

History of original corner establishment:

Not Set.

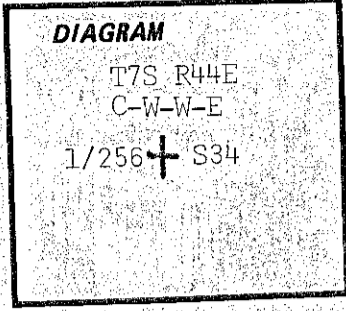

Description of corner evidence found:

None Found.

Description of monument and accessories I established to perpetuate the original location of this corner:

At surveyed point set 2 1/2" X 30" aluminum pipe and cap marked:
Set pipe 24" in the ground and mound of stone around to cap.
From which by magnetic declination of N20°E:
A 6" Pine bears N35°E, 26.0 ft. scribed C/W/W/E 1/256 S34
BT. A 7" Fir bears S14°E, 25.9 ft. scribed C/W/W/E 1/256 S34 BT. Placed 54-3s, 54-9s and brass washers stamped PLS 1051 on the bearing trees. Placed 54-2 and 54-9 on a steel fence post 5' south and placed 54-2 on a steel fence post 5' west of the corner.

T7S R44E
C/W/W/E
1/256 + S34
OR PLS 1051
1985

I hereby certify that the above corner monument was established as herein described.

Witnesses: Orville G. Allen
Joseph M. Gaarsland

May 23, 1985.

REGISTERED
PROFESSIONAL
LAND SURVEYOR

Barry B. Barbour

OREGON
OCT. 17, 1975
BARRY B. BARBOUR
1051

Office of.....County.....Surveyor..... County of.....Baker.....
State of.....Oregon....., I hereby certify that the within instrument was filed in this office
for record on the..... day of....., 1985.

..... by
(COUNTY OFFICIAL) (DEPUTY)

11-7-85
BAKER COUNTY SURVEYOR
SURVEY NO 7-44-201