


CERTIFIED RECORD OF LAND CORNER MONUMENTATION

Index File Number X-14 (-0.25)

History of original corner establishment:

Not Set.

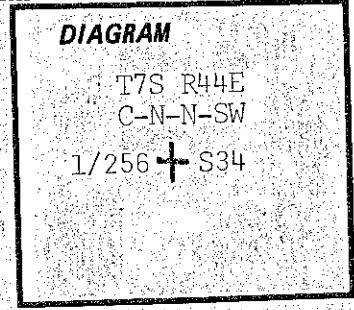

Description of corner evidence found:

None Found.

Description of monument and accessories established to perpetuate the original location of this corner:

At surveyed point set 2 1/2" X 30" aluminum pipe and cap marked:  
Set pipe 22" in the ground and mound of stone around to cap.  
From which by magnetic declination of N20°E:  
An 8" Fir bears S45°E, 26.0 ft. scribed C/N/N/SW 1/256 S34  
BT. A 14" Fir bears N26°W, 97.8 ft. scribed C/N/N/SW 1/256 S34 BT. Painted blazes red and 6" red band around. Placed 54-3s, 54-9s and brass washers stamped PLS 1051 on the bearing trees. Placed 54-2 and 54-9 on a steel fence post 5' south and placed 54-2 on a steel fence post 5' west of the corner.

T7S R44E  
C/N/N/SW  
1/256 + S34  
OR PLS 1051  
1985

I Hereby certify that the above corner monument was established as herein described.

Witnesses: Daniel J. McMillan  
John C. Austin

June 14, 1985.

REGISTERED  
PROFESSIONAL  
LAND SURVEYOR

*Barry B. Barbour*  
OREGON  
OCT. 17, 1975  
BARRY B. BARBOUR  
1051

Office of.....County Surveyor..... County of..... Baker.....  
State of..... Oregon....., I hereby certify that the within instrument was filed in this office  
for record on the..... day of....., 1985.  
..... by .....  
(COUNTY OFFICIAL) (DEPUTY)

Form R6-7100-57 (9/71)

FILED 11-7-85  
BAKER COUNTY SURVEYOR  
SURVEY NO. 7-44-203