


CERTIFIED RECORD OF LAND CORNER MONUMENTATION

Index File Number Y-14.75

History of original corner establishment:

Not Set.

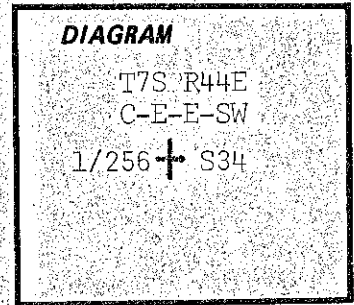

Description of corner evidence found:

None Found.

Description of monument and accessories established to perpetuate the original location of this corner:

At surveyed point set 2 1/2" X 30" aluminum pipe and cap marked: T7S R44E  
C/E/E/SW  
Set pipe 22" in the ground and mound of stone around to cap. 1/256 + S34  
From which by magnetic declination of N20°E: OR PLS 1051  
A 15" Pine bears N79°E, 3.0 ft. scribed C/E/E/SW 1/256 S34 BT. 1985  
A 12" Pine bears S12°W, 15.7 ft. scribed C/E/E/SW 1/256 S34  
BT. Painted blazes red and 6" red band around. Placed 54-3s, 54-4s and brass washers stamped PLS 1051 on the bearing trees. Placed 54-2 and 54-9 on a steel fence post 5' north and placed 54-2 on a steel fence post 5' east of the corner.

I hereby certify that the above corner monument was established as herein described.

Witnesses: Daniel J. McMillan  
John C. Austin

June 22, 1985.

REGISTERED  
PROFESSIONAL  
LAND SURVEYOR

*Barry B. Barbour*

OREGON  
OCT. 17, 1975  
BARRY B. BARBOUR  
1031

Office of..... County Surveyor..... County of..... Baker.....  
State of..... Oregon..... I hereby certify that the within instrument was filed in this office  
for record on the..... day of....., 19.85

(COUNTY OFFICIAL)

(DEPUTY)

FILED 11-7-85  
BAKER COUNTY SURVEYOR  
SURVEY NO. 7-44-206