

CERTIFIED RECORD OF LAND CORNER MONUMENTATION


History of original corner establishment:

Corner established by W. L. Hanley and recorded under Baker County Survey No. 7-44-11, filed October 4, 1978.

Record of survey states:

Set a 5/8 inch x 30 inch rebar.

B-1

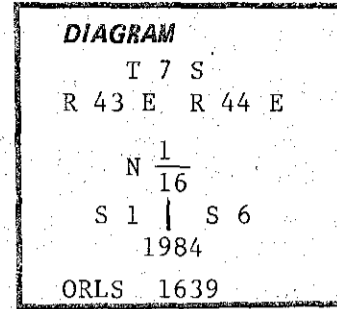

Description of corner evidence found:

Found a 5/8 inch x 30 inch rebar with yellow plastic cap marked R P E 2808.

NOTE: This found rebar bears S49°05'03"E, 1.42 ft dist from corner position established this survey.

Description of monument and accessories established to perpetuate the original location of this corner:

Set 2½" aluminum cap on 2" aluminum pipe 31" long buried 27" in ground with 4" proj. from ground with surrounding rock mound and 6' steel fence post alongside with sign 54-9 attached. Buried rebar alongside.

Aluminum cap marked as shown in corner diagram.

New bearing trees established:

A fir 6 ins dia bears N46°E, 6.9 ft marked N1/16S6 BT.
A fir 9 ins dia bears S54°W, 37.1 ft marked N1/16S1 BT.

Each new bearing tree has a brass washer marked PLS 1639 nailed flush with BT blaze and has signs 54-3 and 54-9 attached below a 6 inch band of red paint.

I hereby certify that the above described corner monument was properly established by me on Nov. 20, 1984 and witnessed by Jim DeMastus and Daryl Schuchardt.

Jim DeMastus

REGISTERED
PROFESSIONAL
LAND SURVEYOR

William L. Hanley
OREGON
JULY 14, 1978
WILLIAM L. HANLEY
1639

Office of.....County..Surveyor..... County of...Baker.....

State of.....Oregon....., I hereby certify that the within instrument was filed in this office

for record on the..... day of....., 19.....

..... by

(COUNTY OFFICIAL)

(DEPUTY)

Form R6-7100-57 (9/71)

☆ U.S. GOVERNMENT PRINTING OFFICE - 1983-793-276

FILED 4-28-86

BAKER COUNTY SURVEYOR

SURVEY NO. 7-44-209