


CERTIFIED RECORD OF LAND CORNER MONUMENTATION

History of original corner establishment:  
None, corner established this survey.

C-3

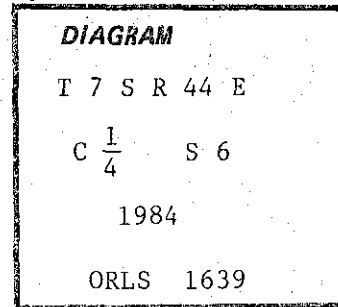

Description of corner evidence found:

None.

Description of monument and accessories I established to perpetuate the original location of this corner:

Set 2½" aluminum cap on 2" aluminum pipe 31" long buried 27" in ground with 4" proj. out of ground encased with 90 lbs of concrete with a 6' steel fence post alongside with sign 54-9 attached.

Aluminum cap marked as shown in corner diagram.

New bearing trees established:

A tamarack 10 ins dia bears N86°W, 13.5 ft marked C1/4S6 BT.  
A spruce 7 ins dia bears S05°E, 11.4 ft marked C1/4S6 BT.

Each new bearing tree has a brass washer marked PLS 1639 nailed flush with BT blaze and has signs 54-3 and 54-9 attached below a 6 inch band of red paint.

I hereby certify that the above described corner monument was properly established by me on Nov. 23, 1984 and witnessed by Jim DeMastus and Daryl Schuchardt.

*Jim DeMastus*

REGISTERED  
PROFESSIONAL  
LAND SURVEYOR

*William L Hanley*

OREGON  
JULY 14, 1978  
WILLIAM L. HANLEY  
1639

Office of.....County..Surveyor..... County of... Baker.....

State of..... Oregon....., I hereby certify that the within instrument was filed in this office for record on the..... day of....., 19.....

..... by .....  
(COUNTY OFFICIAL) (DEPUTY)

FILED 4-28-86  
BAKER COUNTY SURVEYOR  
SURVEY NO. 7-44-215