

CERTIFIED RECORD OF LAND CORNER MONUMENTATION


History of original corner establishment:

Corner established by W. L. Hanley and recorded under Baker County Survey No. 7-44-11, filed October 4, 1978.

Record of survey states:

Set a 5/8 inch x 30 inch rebar.

C-6

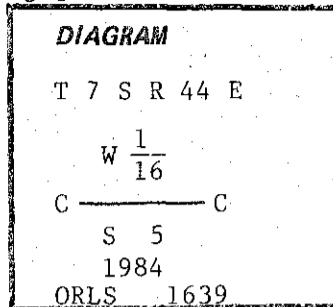

Description of corner evidence found:

Found a 5/8 inch x 30 inch rebar with yellow plastic cap marked R P E 2808.

NOTE: This found rebar bears S58°35'42"E, 1.22 ft dist from corner position established this survey.

Description of monument and accessories I established to perpetuate the original location of this corner:

Set 2 1/2" aluminum cap on 2" aluminum pipe 31" long buried 27" in ground with 4" proj. from ground with surrounding rock mound and 6' steel fence post alongside with sign 54-9 attached. Buried rebar alongside.

Aluminum cap marked as shown in corner diagram.

New bearing trees established:

A pine 10 ins dia bears N24°E, 36.3 ft dist marked CW1/16S5 BT.  
A fir 10 ins dia bears N45°E, 38.5 ft dist marked CW1/16S5 BT.

Each new bearing tree has a brass washer marked PLS 1639 nailed flush with BT blaze and has signs 54-3 and 54-9 attached below a 6 inch band of red paint.

I hereby certify that the above described corner monument was properly established by me on Nov. 07, 1984 and witnessed by Jim DeMastus and Daryl Schuchardt.

*Jim DeMastus*

REGISTERED  
PROFESSIONAL  
LAND SURVEYOR

*William L. Hanley*

OREGON  
JULY 14, 1978  
WILLIAM L. HANLEY  
1639

Office of.....County Surveyor..... County of Baker  
State of Oregon....., I hereby certify that the within instrument was filed in this office  
for record on the..... day of....., 19.....

..... by .....  
(COUNTY OFFICIAL) (DEPUTY)

FILED 4-28-86  
BAKER COUNTY SURVEYOR  
SURVEY NO. 7-44-218