


CERTIFIED RECORD OF LAND CORNER MONUMENTATION

History of original corner establishment:
None, corner established this survey.

C-7

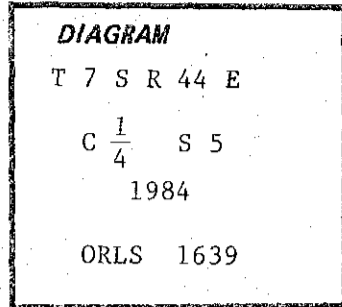

Description of corner evidence found:
None.

Description of monument and accessories established to perpetuate the original location of this corner:
Set 2½" aluminum cap on 2" aluminum pipe 31" long buried 27" in ground with 4" proj. from ground with surrounding rock mound and 6' steel fence post alongside with sign 54-9 attached.

Aluminum cap marked as shown in corner diagram.

New bearing trees established:

A fir 10 ins dia bears N48°W, 34.1 ft dist marked C1/4S5 BT.
A pine 9 ins dia bears S89°W, 54.9 ft dist marked C1/4S5 BT.

Each new bearing tree has a brass washer marked PLS 1639 nailed flush with BT blaze and has signs 54-3 and 54-9 attached below a 6 inch band of red paint.

I hereby certify that the above described corner monument was properly established by me on Nov. 7, 1984 and witnessed by Jim DeMastus and Daryl Schuchardt.

Jim DeMastus



Office of...County..Surveyor..... County of..Baker.....
State of...Oregon....., I hereby certify that the within instrument was filed in this office
for record on the..... day of....., 19.....

..... by
(COUNTY OFFICIAL) (DEPUTY)

FILED 4-28-86
BAKER COUNTY SURVEYOR
SURVEY NO. 7-44-219